


LABOR AND MATERIALS

1 Copper } Connection 3/4" \$
 Lead }
 1 Curb } Cock } 3/4 in. (MARK "ORISEAL") \$
 Valve }
 1 Service box } Short 3 1/2 x 4 1/2 } SAME BOX
 Old returned } Long 4 1/2 x 5 1/2 } \$
 Buff or Redway }
 12 Ft. 3/4 in. } Copper } Pipe at \$
 Nipples in. at \$
 Bushings to in. at \$
 Red'g } Coupl'gs to in. at \$
 Inc'g }
 Union in. at \$
 Meter in. at \$
 Lead Joints at \$
 Compound Joints at \$
 Maintenance Foreman \$
 Hrs. Water Maint. Man-1 at \$
 Hrs. Water Maint. Man-2 at \$
 Hrs. Garage Foreman at \$
 Hrs. Labor at \$
 Hrs. Compressor at \$
 Compensation Ins. at \$ per C \$
 Trucking \$
 Pav't Patch \$
 TAP MADE BY ST JOHN & CO \$
 O'head Sept 26-1972 \$
 \$

182 SOUTH

St.
 South Ave. No. 182
 Name of Owner
 JACK Behrend

Labor and Mat'l. Report Sept 26 1972

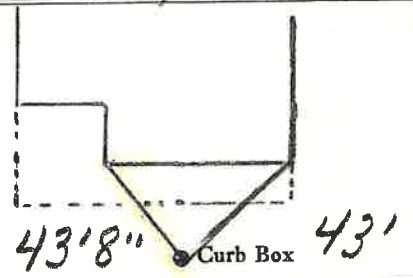

6" Main Elev. of Main at tap 5'
 Gate at • Gate at
 12' to main
 3/4" copper • Curb Box

ORISEAL
 TAX ID # 309.12-11-39