


South

St. Pt. Ave. No. 28

Name of Owner

Labor and Mat'l. Report

1914

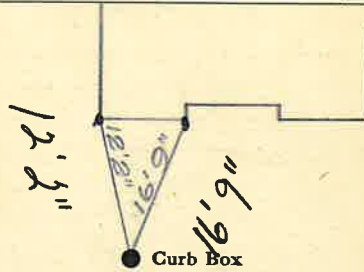

Main

Elev. of Main at tap

Gate at

Gate at

Curb Box


22-15
South

St. Pt. Ave. No. 3030 1/2

Name of Owner

Labor and Mat'l. Report

Aug 9 1945

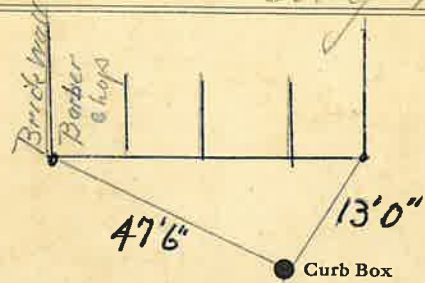

10 Main

Elev. of Main at tap 7

Gate at

Gate at

7' to main
3/4" copper

Curb Box

Labor and Materials

Copper	}	Connection.....	\$.....
Lead			
Curb	}	Cock Valve in \$.....
		T. S. & V.	
Service Box		Short 3½ x 4½	}
Old returned	Long 4½ x 5½		
		Buff. or Rdway	
Ft. in.	}	Copper	Pipe at \$.....
		Galv Iron	
		Cast Iron	
Nipples in. at		\$.....
Bushings to in. at	\$.....
Red'g	}	Conplings..... to in. at \$.....
Inc'g			
Union in. at		\$.....
Meter in. at		\$.....
Lead Joints	at		\$.....
Leadite Joints	at		\$.....
Hrs. Foreman	at		\$.....
Hrs. Chauffeur	at		\$.....
Hrs. Tapper	at		\$.....
Hrs. Labor	at		\$.....
Hrs. Labor	at		\$.....
Hrs. Compressor	at		\$.....
Compensation Ins.		\$.....
Trucking		\$.....
Builders Use of Water		\$.....
			\$.....
			\$.....
24-30 SOUTH

St. _____
Pl. _____
Ave. No. 24-30

Name of Owner _____

TAX ID # 302.20-28-17

Labor and Mat'l. Report 19

● Curb Box

10 Main Elev. of Main at tap 16

Gate at ● ● Gate at

● Curb Box