


LABOR AND MATERIALS

1	Copper	Connection	3/4"	\$
1	Curb	Cock	3/4 in. ORISEAL	\$
1	Service box	Short 3 1/2 x 4 1/2		\$
	Old returned	Long 4 1/2 x 5 1/2		\$
		Buff or Redway		\$
21' 7"	3/4 in.	Copper	Pipe at	\$
				\$
	Nipples	in. at		\$
	Bushings	to in. at		\$
	Red'g			\$
	Inc'g	Coupl'gs. to in. at		\$
	Union	in. at		\$
	Meter	in. at		\$
	Lead Joints	at		\$
	Compound Joints	at		\$
	Maintenance Foreman			\$
	Hrs. Water Maint. Man-1	at		\$
	Hrs. Water Maint. Man-2	at		\$
	Hrs. Garage Foreman	at		\$
	Hrs. Labor	at		\$
	Hrs. Compressor	at		\$
	Compensation Ins. at \$	per C		\$
	Trucking			\$
	Pav't Patch			\$
	Tap By St. John & Co			\$
	July-22-1976			\$
	O'head			\$

St. South
 Pl. Ave. No. 187
 Name of Owner John Kennitzer

Labor and Mat'l. Report July 22 1976

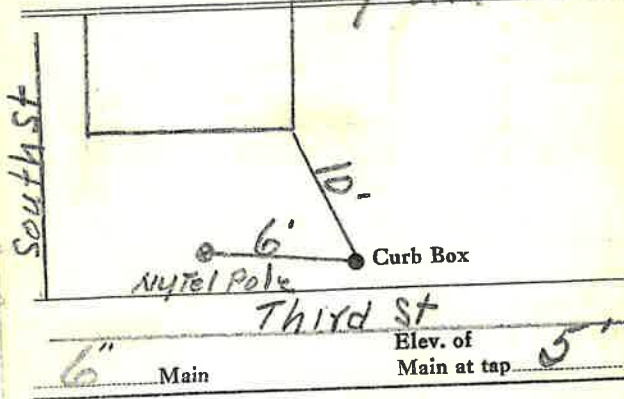

6" Main Gate at • Gate at •

21' 7" to main

3/4" copper • Curb Box

TAP ON Third St

ORISEAL
 TAX ID# 309.12-13-5