

Labor and Materials

| | | |
|-----|---|--------------------|
| 1 | Copper } Connection ^{3/4} | \$ 1.25 |
| | Lead } | |
| 1 | Curb { Cock Valve T.S.&V. } ^{3/4} in | \$ 1.70 |
| 1 | Service Box { Short 3 1/2 x 4 1/2 } | \$ 1.37 |
| | Old returned { Long 4 1/2 x 5 1/2 } | |
| | | { Buff. or Rdway } |
| 2.8 | Ft. 1/4 in. { Copper Galv. Iron } Pipe at 1 1/2 x | \$ 2.11 |
| | | { Cast Iron } |
| | Nipples in. at | \$ |
| | Bushings to in. at | \$ |
| | Red'g Inc'g } Couplings..... to in. at | \$ |
| | Union..... in. at | \$ |
| | Meter..... in. at | \$ |
| | Lbs. Br. Stone at | \$ |
| | Lbs. Sand at | \$ |
| | Bags Cement at | \$ |
| | Paving Brick { Mack Red Asphalt } at | \$ |
| | Lead Joints at | \$ |
| | Leadite Joints at | \$ |
| 7 | Hrs. Foreman at ^{6 1/2 hr} | \$ 4.38 |
| 8 | Hrs. Common Labor at ⁵⁰ | \$ 4.- |
| 6 | Hrs. Common Labor at ⁴⁵ | \$ 1.80 |
| | Hrs. Mason at | \$ |
| | Hrs. Masons Helper at | \$ |
| A | Hrs. Compressor at ^{1.50} | \$ 6.- |
| | Compensation Ins | \$.38 |
| | Trucking | \$ 1.- |
| | Builders Use of Water Patch | \$ 9.- |


Total \$32.99..

1935-166 189 SOUTH

Labor and Material Report Nov 26

1935

1/4 tap at 189 South St

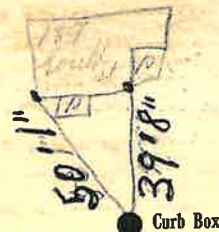

Curb Box

6" Main

Elev of Main at tap ^{4/2}

Gate at ^{2 3'} to main
3/4" copper

● Gate at

Curb Box

Old tap at 189 South St

*To be raised
6-29-65*

TAX ID # 309.12-13-4

[Signature]