


SOUTH

St. Pl. Ave. No. 190

Name of Owner

TAX ID # 309.12-11-48

Labor and Mat'l. Report 19

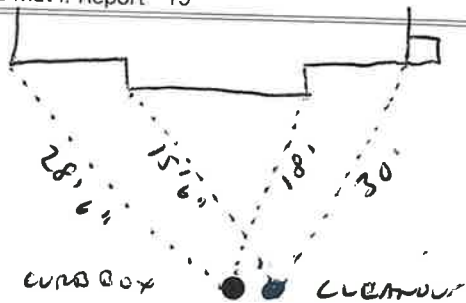

MORRISON PL.

Main

Elev. of Main at tap

Gate at ●

● Gate at

● Curb Box


South

St. Pl. Ave. No. 190

Name of Owner

Labor and Mat'l. Report

19

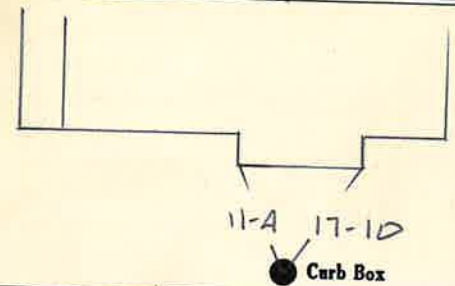

South St.

Main HARTISON PL.

Elev. of Main at tap

Gate at ●

● Gate at

8' 10" to MAIN
3/4" COPPER

● Curb Box

