

LABOR AND MATERIALS

1 Copper } Connection  $\frac{3}{4}$ " \$  
 1 Curb } Cock Valve }  $\frac{3}{4}$ " in. (MARKED ORIGINAL) \$  
 1 Service box } Short  $3\frac{1}{2}$  x  $4\frac{1}{2}$  } SAME BOX \$  
 Old returned } Long  $4\frac{1}{2}$  x  $6\frac{1}{2}$  } \$  
 } Buff or Rdway } \$  
 11 Ft.  $\frac{3}{4}$ " in. } Copper } Pipe at \$  
 } } \$  
 Nipples in. at \$  
 Bushings to in. at \$  
 Red'g } Coupl'gs to in. at \$  
 Inc'g } } \$  
 Union in. at \$  
 Meter in. at \$  
 Lead Joints at \$  
 Compound Joints at \$  
 Maintenance Foreman \$  
 Hrs. Water Maint. Man-1 at \$  
 Hrs. Water Maint. Man-2 at \$  
 Hrs. Garage Foreman at \$  
 Hrs. Labor at \$  
 Hrs. Compressor at \$  
 Compensation Ins. at \$ per C \$  
 Trucking \$  
 Pav't Patch \$  
 TAP MADE BY ST JOHN & CO \$  
 Sept 22-1972 \$  
 O'head \$

South


St. No. 196

Name of Owner

TERRY ALLEN

Labor and Mat'l. Report

Sept 22 1972

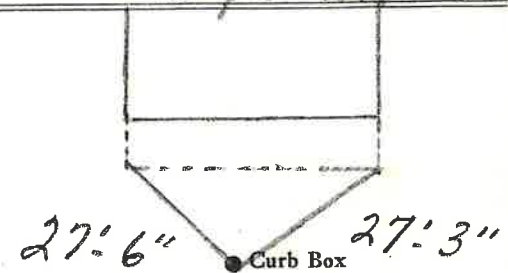

6" Main

Elev. of Main at tap 5'

Gate at • Gate at

11' to MAIN  
 $\frac{3}{4}$ " COPPER

ORISEAL • Curb Box

TAX ID # 309.12-11-50