


### Labor and Materials

.....	Copper } Connection.	3	.....	\$
.....	Lead } .....		.....	\$
.....	Curb { Cock		.....	\$
.....	Valve } .....		.....	\$
.....	T. S. & V. } .....		.....	\$
.....	Service Box { Short 3 1/2 x 4 1/2		.....	\$
.....	Old returned { Long 4 1/2 x 5 1/2		.....	\$
.....	Buff. or Rdway } .....		.....	\$
24	Ft. .... in. { Copper		.....	\$
.....	Galv. Iron } Pipe at		.....	\$
.....	Cast Iron } .....		.....	\$
.....	Nipples..... in. at		.....	\$
.....	Bushings..... to .....	in. at	.....	\$
.....	Red'g } Couplings..... to .....	in. at	.....	\$
.....	Inc'g } .....		.....	\$
.....	Union..... in. at		.....	\$
.....	Meter..... in. at		.....	\$
.....	Lbs. Br. Stone at		.....	\$
.....	Lbs. Sand at		.....	\$
.....	Bags Cement at		.....	\$
.....	Paving Brick { Mack		.....	\$
.....	Red } at		.....	\$
.....	Asphalt } .....		.....	\$
.....	Lead Joints at		.....	\$
.....	Leadite Joints at		.....	\$
5	Hrs. Foreman at		.....	\$
2	Hrs. Common Labor at	50	.....	\$
15	Hrs. Common Labor at		.....	\$
.....	Hrs. Mason at		.....	\$
.....	Hrs. Mason's Helper at		.....	\$
.....	Hrs. Compressor at		.....	\$
.....	Compensation Ins.		.....	\$
.....	Trucking		.....	\$
.....	Builders' Use of Water		.....	\$
Total \$				.....

27-202

### Labor and Material Report

19

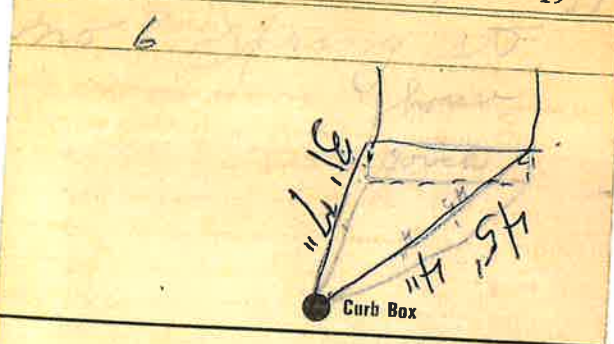

Gate at 24' to MAIN

Main

Elev. of Main at tap 5'

Gate at

Curb Box

Old Tap Shut off

TAX ID# 309.12-1-1