

LABOR AND MATERIALS

1	Copper Lead	Connection	3/4		\$ 2.94
1	Curb	Cock Valve T. S. & V.	3/4 in.		\$ 3.71
1	Service box Old returned	Short 3/4 X 4 1/2 Long 4 1/2 X 5 1/2 Buff or Rdway			\$ 5.90
10	Ft.	Copper Pipe at	3/4 in.	30	\$ 3.00
	Nipples		in.	at	\$
	Bushings		to	in.	at \$
	Red'g Inc'g	Coupl'gs	to	in.	at \$
	Union		in.	at	\$
	Meter		in.	at	\$
	Lead Joints			at	\$
	Compound Joints			at	\$
3	Hrs. Water Maint. Man-1		at	1.01	\$ 3.03
4	Hrs. Water Maint. Man-2		at	91	\$ 3.64
12	Hrs. Labor		at	80	\$ 9.60
	Hrs. Labor		at		\$
	Hrs. Compressor		at		\$
	Compensation Ins.		at \$	per C	\$ 36
	Trucking				\$ 1.00
	Pav't Patch	Before paving			\$
	Top 4' Milling				\$
	O'head				\$
					\$ 33.18

100

St.
Pl.
Ave. No. 9


Spring

Name of Owner

Cochran

Labor and Mat'l. Report

June 11 1948

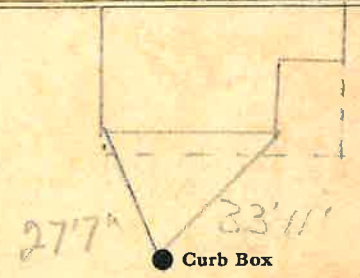

Main Elev. of Main at tap 5

Gate at ● ● Gate at

10' to main

3/4" copper ● Curb Box

To be Billed