

LABOR AND MATERIALS

1	Copper Lead	Connection	$\frac{3}{4}$		\$1.35	
1	Curb	Cock Valve T.S. & V.	$\frac{3}{4}$ in.		\$1.88	
1	Service Box Old returned	Short $3\frac{1}{2} \times 4\frac{1}{2}$ Long $4\frac{1}{2} \times 5\frac{1}{2}$ Buff. or Rdway			\$1.82	
26	Ft.		$3\frac{3}{4}$ in.	Pipe at	\$5.20	
	Nipples	in.	at		\$	
	Bushings	to	in.	at	\$	
	Red'g Inc'g	Couplings	to	in.	at	\$
	Union	in.	at		\$	
	Meter	in.	at		\$	
	Lead Joints	at			\$	
	Leadite Joints	at			\$	
	Hrs. Foreman	at			\$	
10	Hrs. Chauffeur	at	62.34		\$6.88	
11	Hrs. Tapper	at	7		\$7.56	
5	Hrs. Labor	at	55		\$2.75	
	Hrs. Labor	at			\$	
1	Hrs. Compressor	at	.92		\$.92	
	Compensation Ins.				\$53	
	Trucking				\$1-	
	Builders Use of Water	Patch			\$5.-	
		Top by Warsinski			\$	
					\$	
					\$	
					\$	
					\$	
					\$34.89	


H.

34 1942

St. Spring
Pt. Ave. No. 14

Name of Owner Loren H Barney

Labor and Mat'l Report June 3 1942

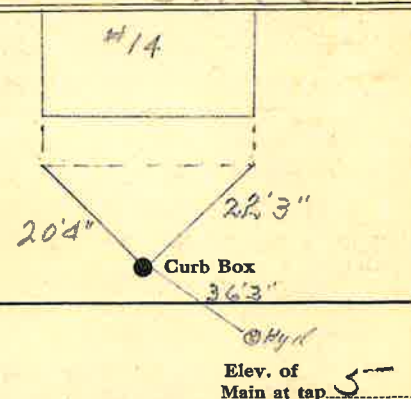

7 Main Elev. of Main at tap 5

Gate at ● Gate at ●

26" to MAIN

● Curb Box

TAX ID# 309.35-4-3

H.