


Labor and Material Report

Aug 25

1928

3/4" tap on staple at lot 16 West
staple at hyd. staple at *side*
→
going South

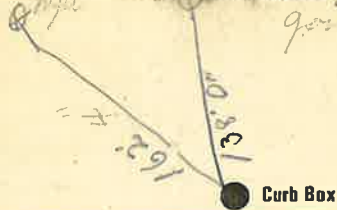

Main

Elev of Main at tap

Gate at ●

● Gate at


● Curb Box

Labor and Material Report

Aug 24

1928

3/4" tap at 16 staple at

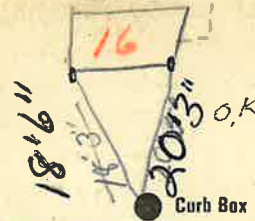

6" Main

Elev of Main at tap

Gate at ●

8' to MAIN

● Gate at

3/4" copper

● Curb Box

Mr. Butler

TAX ID # 309.11-7-18

Labor and Materials

1	Copper	Connection	3/4	\$
	Lead			
1	Curb	Cock Valve T.S. & V.	3/4 in.	\$
1	Service Box	Short 3/8 x 1/2	}	\$
	Old returned	Long 4/8 x 5/8		
		Buff. or Rdway		
2 1/2	Pt.	Copper Galv. Iron Cast Iron	Pipe at	\$
	Nipples	in. at		\$
	Bushings	to in. at		\$
	Red'g Inc'g	Couplings	to in. at	\$
	Union	in. at		\$
	Meter	in. at		\$
	Lbs. Br. Stone	at		\$
	Lbs. Sand	at		\$
	Bags Cement	'at		\$
	Paving Brick	Mack Red Asphalt	at	\$
	Lead Joints	at		\$
	Leadite Joints	at		\$
	Hrs. Foreman	at		\$
	Hrs. Common Labor	at		\$
	Hrs. Common Labor	at		\$
	Hrs. Mason	at		\$
	Hrs. Mason's Helper	at		\$
	Hrs. Compressor	at		\$
	Compensation Ins			\$
	Trucking			\$
	Builders' Use of Water			\$
	Total \$			\$

Labor and Materials


1	Copper	Connection	3/4	\$
	Lead			
1	Curb	Cock Valve T.S. & V.	3/4 in.	\$
1	Service Box	Short 3/8 x 1/2	}	\$
	Old returned	Long 4/8 x 5/8		
		Buff. or Rdway		
8	Pt.	Copper Galv. Iron Cast Iron	Pipe at	\$
	Nipples	in. at		\$
1	Bushings	to in. at		\$
	Red'g Inc'g	Couplings	to in. at	\$
	Union	in. at		\$
	Meter	in. at		\$
	Lbs. Br. Stone	at		\$
	Lbs. Sand	at		\$
	Bags Cement	'at		\$
	Paving Brick	Mack Red Asphalt	at	\$
	Lead Joints	at		\$
	Leadite Joints	at		\$
	Hrs. Foreman	at		\$
	Hrs. Common Labor	at		\$
	Hrs. Common Labor	at		\$
	Hrs. Mason	at		\$
	Hrs. Mason's Helper	at		\$
	Hrs. Compressor	at		\$
	Compensation Ins			\$
	Trucking			\$
	Builders' Use of Water			\$
	Total \$			\$

Labor and Materials

1. Lead Connection	\$.....
1. Curb Cock	\$.....
1. Service Box (Short 3½ x 4½ Old returned (Long 4½ x 5½ Buffalo)	\$.....
1.2. Ft. ¾ in. G.F. Pipe at.....	\$.....
Nipples..... in. at.....	\$.....
Bushings..... to..... in. at.....	\$.....
Red'g Coup..... to..... in. at.....	\$.....
Inc'g Coup..... to..... in. at.....	\$.....
Union..... in. at.....	\$.....
Meter..... in. at.....	\$.....
Cu. Yds. Br. Stone at.....	\$.....
Cu. Yds. Sand at.....	\$.....
Bags Cement at.....	\$.....
Paving Brick (Mack Red Asphalt) at.....	\$.....
Hrs. Foreman at.....	\$.....
Hrs. Common Labor at.....	\$.....
Hrs. Mason at.....	\$.....
Hrs..... at.....	\$.....
Hrs..... at.....	\$.....
Builders' Use of Water	\$.....
..... at.....	\$.....
..... at.....	\$.....
Total \$.....	\$.....

Labor and Material Report July 10 1928

See 16 staples at

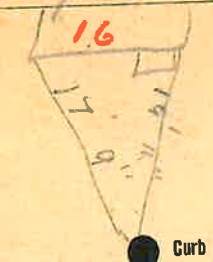

Curb Box

6 Main Elev. of Main at tap 5'
Gate at ● Gate at ●

Curb Box