


Labor and Materials

1	Copper	Connection	3/4	\$
	Lead			
1	Curb	Cock Valve P.S. & V.	3/4 in.	\$
1	Service Box	Short 3/4 x 1/2		\$
	Old returned	Long 1 1/2 x 5/8		\$
		Bull. or Rdway		\$
26	Ft.	3/4 in. Copper Galv. Iron Pipe at		\$
		Cast Iron		\$
	Nipples	in. at		\$
1	Bushing	to 1/2 in. at		\$
	Red'g Inc'g	Couplings to in. at		\$
	Union	in. at		\$
	Meter	in. at		\$
	Lbs. Br. Stone	at		\$
	Lbs. Sand	at		\$
	Bags Cement	at		\$
	Paving Brick	Mack Red Asphalt at		\$
	Lead Joints	at		\$
	Leadite Joints	at		\$
	Hrs. Foreman	at		\$
	Hrs. Common Labor	at		\$
	Hrs. Common Labor	at		\$
	Hrs. Mason	at		\$
	Hrs. Mason's Helper	at		\$
	Hrs. Compressor	at		\$
	Compensation Ins.			\$
	Trucking			\$
	Builders' Use of Water			\$
	Total	\$		

23  
25 Slope at

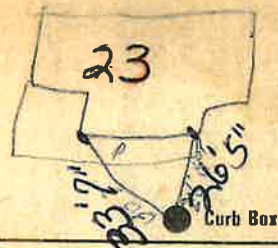

6" Main

Elev of Main at tap 4.11

Gate at

Gate at

26' TO MAIN  
3/4" COPPER

25' TO MAIN ● Curb Box  
KIT 10/11/07

Geo Anderson

NEW CURB VALVE  
INSTALLED 10/11/2007  
TAX ID # 309.11-5-6