


### Labor and Materials

.....Lead Connection .....	\$.....
.....Curb Cock.....	\$.....
.....Service Box (Short 3" x 4"	
.....Old returned (Long 4" x 6"	\$.....
.....Ft. 2" in. G-I Pipe at.....	\$.....
.....Nipples.....in. at.....	\$.....
.....Bushings.....to.....in. at.....	\$.....
.....Red'g Coup.....to.....in. at.....	\$.....
.....Inc'g Coup.....to.....in. at.....	\$.....
.....Union.....in. at.....	\$.....
.....Meter.....in. at.....	\$.....
.....Cu. Yds. Br. Stone at.....	\$.....
.....Cu. Yds. Sand at.....	\$.....
.....Bags Cement at.....	\$.....
.....Paving Brick { Mack Red Asphalt } at.....	\$.....
.....Hrs. Foreman at.....	\$.....
.....Hrs. Common Labor at.....	\$.....
.....Hrs. Mason at.....	\$.....
.....Hrs.....at.....	\$.....
.....Hrs.....at.....	\$.....
.....Builders' Use of Water.....	\$.....
.....at.....	\$.....
.....at.....	\$.....
.....Total	\$.....

### Labor and Material Report July 11 1922

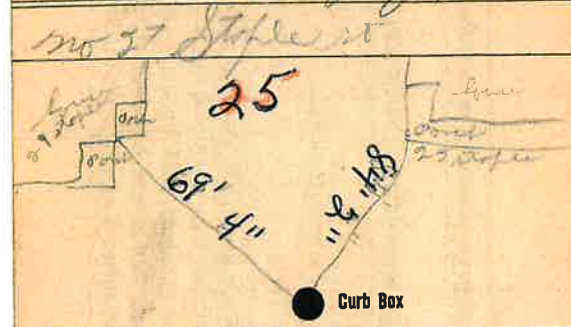

Elev. of Main at tap 4

Gate at ● ● Gate at

20' to MAIN

● Curb Box