


31 Staple St
Labor and Material Report Aug 24 1928

3/4" Vacant lot west side Staple St
going south ←

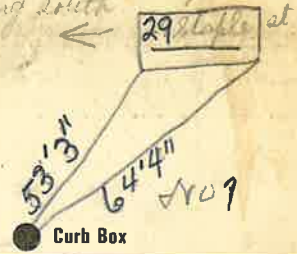


6" Main Elev of Main at tap 4.6 ft

Gate at ● Gate at ●

● Curb Box

29
Labor and Material Report Aug 24 1928

3/4" tap at 29 Staple St

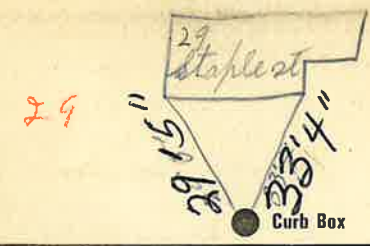

6" Main Elev of Main at tap 4.1 ft

Gate at ● Gate at ●
24" to MAIN

3/4" copper ● Curb Box

Mrs William Dee
BOX NEAR CORNER
DRIVEWAY

TAX ID# 309.11-5-4

Labor and Materials

1	Copper	Lead	Connection	3/4		\$
1	Curb	Cock Valve	T-S & V.	3/4	in.	\$
1	Service Box	Short 3/4x1 1/2	Long 1 1/2x5 1/2			\$
	Old returned	Buff. or Rdway				\$
24	Ft.	3/4	in.	Copper Galv. Iron Cast-Iron	Pipe at	\$
	Nipples		in. at			\$
	Bushings		to in. at			\$
	Red'g Inc'g	Couplings			to in. at	\$
	Union		in. at			\$
	Meter		in. at			\$
	Lbs. Br. Stone		at			\$
	Lbs. Sand		at			\$
	Bags Cement		at			\$
	Paving Brick	Mack Red Asphalt			at	\$
	Lead Joints		at			\$
	Leadite Joints		at			\$
	Hrs. Foreman		at			\$
	Hrs. Common Labor		at			\$
	Hrs. Common Labor		at			\$
	Hrs. Mason		at			\$
	Hrs. Mason's Helper		at			\$
	Hrs. Compressor		at			\$
	Compensation Ins					\$
	Trucking					\$
	Builders' Use of Water					\$
	Total \$					

Labor and Materials

1	Copper	Lead	Connection	3/4		\$
1	Curb	Cock Valve	T-S & V.	3/4	in.	\$
1	Service Box	Short 3/4x1 1/2	Long 1 1/2x5 1/2			\$
	Old returned	Buff. or Rdway				\$
24	Ft.	3/4	in.	Copper Galv. Iron Cast-Iron	Pipe at	\$
	Nipples		in. at			\$
1	Bushings	3/4	to 1/2		in. at	\$
	Red'g Inc'g	Couplings			to in. at	\$
	Union		in. at			\$
	Meter		in. at			\$
	Lbs. Br. Stone		at			\$
	Lbs. Sand		at			\$
	Bags Cement		at			\$
	Paving Brick	Mack Red Asphalt			at	\$
	Lead Joints		at			\$
	Leadite Joints		at			\$
	Hrs. Foreman		at			\$
	Hrs. Common Labor		at			\$
	Hrs. Common Labor		at			\$
	Hrs. Mason		at			\$
	Hrs. Mason's Helper		at			\$
	Hrs. Compressor		at			\$
	Compensation Ins					\$
	Trucking					\$
	Builders' Use of Water					\$
	Total \$					