


3/4" tap in second lot east side No 2

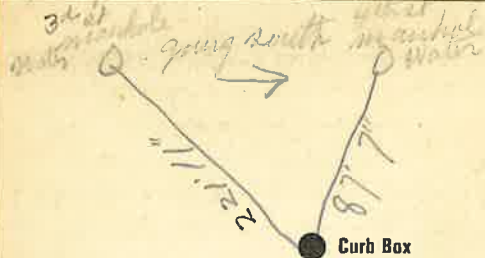


6" Main Elev' of Main at tap *4.4*

Gate at ● Gate at ●

● Curb Box

Pat Hurley

3/4" tap for No 2 Staple St.

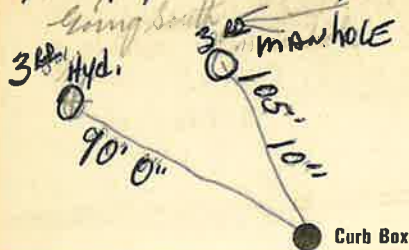

6" Main Elev' of Main at tap *4.4*

Gate at ● Gate at ●

24' to main

● Curb Box

Anna Coffey
#2

Labor and Materials

1	Copper } Connection ^{3/4}		\$
	Lead		
1	Curb } Cock Valve } ^{3/4} in.		\$
		T-S. & V.	
1	Service Box } Short 3 1/2 x 4 1/2 }		\$
	Old returned } Long 4 1/2 x 5 1/2 }		
		Buff. or Rdway	
7	Ft. ^{3/4} in. } Copper } Pipe at		\$
		Galv. Iron	
		Cast Iron	
	Nipples	in. at	\$
	Bushings	to in. at	\$
	Red'g } Couplings	to in. at	\$
	Inc'g		
	Union	in. at	\$
	Meter	in. at	\$
	Lbs. Br. Stone	at	\$
	Lbs. Sand	at	\$
	Bags Cement	at	\$
	Paving Brick } Mack } at		\$
		Red	
		Asphalt	
	Lead Joints	at	\$
	Leadite Joints	at	\$
	Hrs. Foreman	at	\$
	Hrs. Common Labor	at	\$
	Hrs. Common Labor	at	\$
	Hrs. Mason	at	\$
	Hrs. Mason's Helper	at	\$
	Hrs. Compressor	at	\$
	Compensation Ins		\$
	Trucking		\$
	Builders' Use of Water		\$
	Total \$		\$

Labor and Materials

1	Copper } Connection ^{3/4}		\$
	Lead		
1	Curb } Cock Valve } ^{3/4} in.		\$
		T-S. & V.	
1	Service Box } Short 3 1/2 x 4 1/2 }		\$
	Old returned } Long 4 1/2 x 5 1/2 }		
		Buff. or Rdway	
24	Ft. ^{3/4} in. } Copper } Pipe at		\$
		Galv. Iron	
		Cast Iron	
	Nipples	in. at	\$
	Bushings	to in. at	\$
	Red'g } Couplings	to in. at	\$
	Inc'g		
	Union	in. at	\$
	Meter	in. at	\$
	Lbs. Br. Stone	at	\$
	Lbs. Sand	at	\$
	Bags Cement	at	\$
	Paving Brick } Mack } at		\$
		Red	
		Asphalt	
	Lead Joints	at	\$
	Leadite Joints	at	\$
	Hrs. Foreman	at	\$
	Hrs. Common Labor	at	\$
	Hrs. Common Labor	at	\$
	Hrs. Mason	at	\$
	Hrs. Mason's Helper	at	\$
	Hrs. Compressor	at	\$
	Compensation Ins		\$
	Trucking		\$
	Builders' Use of Water		\$
	Total \$		\$