

LABOR AND MATERIALS

Copper } Connection _____	\$ _____
Lead } _____	\$ _____
Curb } Cock _____	in. _____ \$ _____
} Valve _____	
} T. S. & V. _____	
Service box { Short 3 1/2 x 4 1/2 }	_____ \$ _____
Old returned { Long 4 1/2 x 5 1/2 }	_____ \$ _____
Ft. 3/4 in. { Copper } Pipe at _____	\$ _____
} G.I. _____	
} G.I. _____	
Nipples _____ in. at _____	\$ _____
Bushings _____ to _____ in. at _____	\$ _____
Red'g } Coupl'gs _____ to _____ in. at _____	\$ _____
Inc'g } _____	
Union _____ in. at _____	\$ _____
Meter _____ in. at _____	\$ _____
_____	\$ _____
Compound Joints at _____	\$ _____
Maintenance Foreman _____	\$ _____
Hrs. Water Maint. Man—1 at _____	\$ _____
Hrs. Water Maint. Man—2 at _____	\$ _____
Hrs. Garage Foreman _____ at _____	\$ _____
Hrs. Labor _____ at _____	\$ _____
Hrs. Compressor at _____	\$ _____
_____	\$ _____
Trucking _____	\$ _____
Pav't Patch _____	\$ _____
_____	\$ _____
_____	\$ _____
_____	\$ _____
_____	\$ _____

STAPLE


St. Pt. Ave. No. 35

Name of Owner _____

TAX ID # 309.11-5-1

Labor and Mat'l. Report

19 89

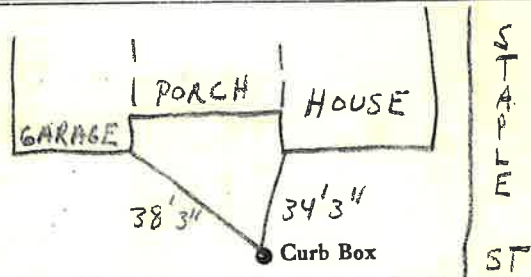

THIRD

ST

Main

Elev. of Main at tap

Gate at •

• Gate at

3/4" COPPER

• Curb Box

TAP ON THIRD ST.