


no 350 staple st.

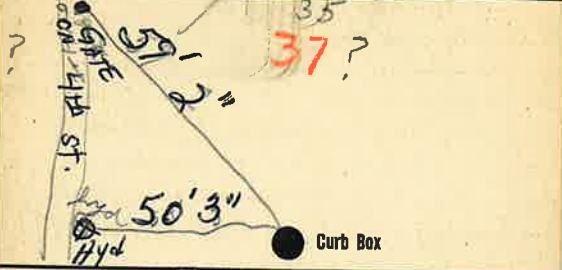


6" Main Elev. of Main at tap

Gate at 20' to main Gate at

3/4" copper Curb Box

TAX ID # 309.11-10-3

3/4" top amount lot West side st 2

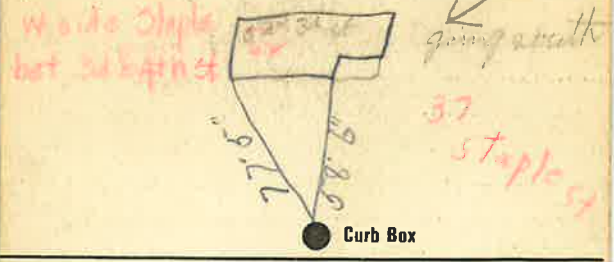

6" Main Elev. of Main at tap

Gate at Gate at

Curb Box

Bethel Vaughn

Measured from West side 62 - 31d st.

