


E. side Staple lot 3d 6411 Ors.  
Labor and Material Report Aug 24 1928

Vacant lot No 6 Staple at corner side

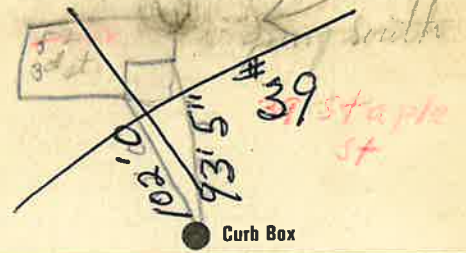

6" Main Elev of Main at tap 4' 4"

Gate at ● Gate at ●  
22' to main  
3/4" Copper


Lot No 33 ● Curb Box

~~Patented~~  
Orlander Mason

~~Measured from~~  
~~62 - 3rd St~~  
~~West side~~

St. Pl. Ave. No. 39  
Name of Owner

Labor and Mat'l. Report # 2004

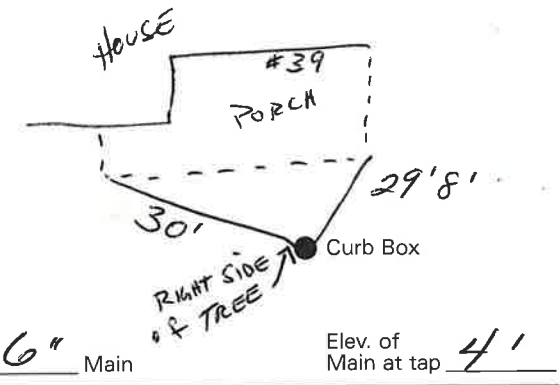

6" Main Elev. of Main at tap 4'

Gate at ● Gate at ●

22' to main 3/4" COPPER

● Curb Box

### Labor and Materials

1 Copper } Connection  $\frac{3}{4}$  ..... \$ .....  
    Lead }  
 1 Curb } Cock }  $\frac{3}{4}$  in. .... \$ .....  
    Valve } T.S. & V. }  
 1 Service Box } Short  $3\frac{1}{2} \times 4\frac{1}{2}$  } ..... \$ .....  
    Old returned } Long  $4\frac{1}{2} \times 5\frac{1}{2}$  }  
                   } Buff. or Rdway }  
 22 Ft.  $\frac{3}{4}$  in. } Copper } Pipe at ..... \$ .....  
                   } Galv. Iron }  
                   } Cast Iron }  
 Nipples ..... in. at ..... \$ .....  
 Bushings ..... to ..... in. at ..... \$ .....  
 Red'g } Couplings ..... to ..... in. at ..... \$ .....  
 Inc'g }  
 Union ..... in. at ..... \$ .....  
 Meter ..... in. at ..... \$ .....  
 Lbs. Br. Stone at ..... \$ .....  
 Lbs. Sand at ..... \$ .....  
 Bags Cement at ..... \$ .....  
 Paving Brick } Mack } at ..... \$ .....  
                   } Red }  
                   } Asphalt }  
 Lead Joints at ..... \$ .....  
 Leadite Joints at ..... \$ .....  
 Hrs. Foreman at ..... \$ .....  
 Hrs. Common Labor at ..... \$ .....  
 Hrs. Common Labor at ..... \$ .....  
 Hrs. Mason at ..... \$ .....  
 Hrs. Mason's Helper at ..... \$ .....  
 Hrs. Compressor at ..... \$ .....  
 Compensation Ins ..... \$ .....  
 Trucking ..... \$ .....  
 Builders' Use of Water ..... \$ .....  
 Total \$ .....

### LABOR AND MATERIALS

1 Copper } Connection  $\frac{3}{4}$  ..... \$ .....  
    Lead }  
 1 Curb } Cock }  $\frac{3}{4}$  in. .... \$ .....  
    Valve } T.S. & V. }  
 1 Service box } Short  $3-1/2 \times 4-1/2$  } ..... \$ .....  
    Old returned } Long  $4-1/2 \times 5-1/2$  }  
 22' Ft.  $\frac{3}{4}$  in. } Copper } Pipe at ..... \$ .....  
                   } Galv. Iron }  
                   } Cast Iron }  
 Nipples ..... in. at ..... \$ .....  
 Bushings ..... to ..... in. at ..... \$ .....  
 Red'g .....  
 Inc'g .....  
 Union ..... in. at ..... \$ .....  
 Meter ..... in. at ..... \$ .....  
 ..... \$ .....  
 Compound Joints at ..... \$ .....  
 Maintenance Foreman ..... \$ .....  
 Hrs. Water Maint. Man - 1 at ..... \$ .....  
 Hrs. Water Maint. Man - 2 at ..... \$ .....  
 Hrs. Garage Foreman ..... at ..... \$ .....  
 Hrs. Labor ..... at ..... \$ .....  
 Hrs. Compressor at ..... \$ .....  
 ..... \$ .....  
 Trucking ..... \$ .....  
 Pav't Patch ..... \$ .....  
 ..... \$ .....  
 ..... \$ .....  
 ..... \$ .....  
 ..... \$ .....