

LABOR AND MATERIALS

Copper } Connection _____	\$ _____
Lead } _____	\$ _____
Curb } Cock _____	\$ _____
} Valve _____	in. _____
} T. S. & V. _____	\$ _____
Service box } Short 3½ x 4½ }	\$ _____
Old returned } Long 4½ x 5½ }	\$ _____
29.5 Ft. 3/4 in. } Copper } Pipe at _____	\$ _____
} G.I. }	\$ _____
} C.I. }	\$ _____
Nipples _____ in. at _____	\$ _____
Bushings _____ to _____ in. at _____	\$ _____
Red'g } Coupl'gs _____ to _____ in. at _____	\$ _____
Inc'g } _____	\$ _____
Union _____ in. at _____	\$ _____
Meter _____ in. at _____	\$ _____
_____	\$ _____
Compound Joints at _____	\$ _____
Maintenance Foreman _____	\$ _____
Hrs. Water Maint. Man—1 at _____	\$ _____
Hrs. Water Maint. Man—2 at _____	\$ _____
Hrs. Garage Foreman _____ at _____	\$ _____
Hrs. Labor— _____ at _____	\$ _____
Hrs. Compressor at _____	\$ _____
_____	\$ _____
Trucking _____	\$ _____
Pav't Patch _____	\$ _____
_____	\$ _____
_____	\$ _____
_____	\$ _____
_____	\$ _____


Staple

St. \_\_\_\_\_  
 Pt. \_\_\_\_\_  
 Ave. No. 53

Name of Owner \_\_\_\_\_

TAX ID # 309.11-12-1

Labor and Mat'l. Report Oct 1988

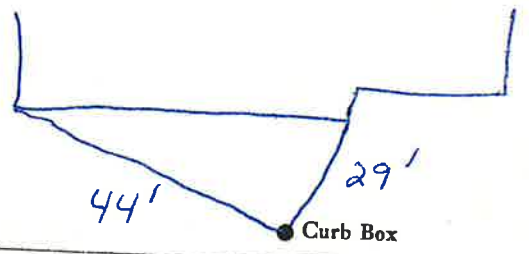

Main \_\_\_\_\_ Elev. of Main at tap \_\_\_\_\_

Gate at • \_\_\_\_\_ Gate at \_\_\_\_\_

29'5" to MAIN

3/4" COPPER • Curb Box