


Labor and Materials

Lead Connection	\$
Curb Cock	\$
Service Box { Short 3½ x 4½	\$
Old returned { Long 4½ x 5½	\$
Buffalo	\$
9 Ft. in. G. I. Pipe at	\$
Nipples in. at	\$
Bushings ½ to ½ in. at	\$
Red'g Coup to in. at	\$
Inc'g Coup to in. at	\$
Union in. at	\$
Meter in. at	\$
Cu. Yds. Br. Stone at	\$
Cu. Yds. Sand at	\$
Bags Cement at	\$
Paving Brick { Mack	\$
Red	\$
Asphalt } at	\$
Hrs. Foreman at	\$
Hrs. Common Labor at	\$
Hrs. Mason at	\$
Hrs. at	\$
Hrs. at	\$
Builders' Use of Water	\$
at	\$
at	\$
Total	\$	

Labor and Material Report July 11 1924

No 56 Maple St

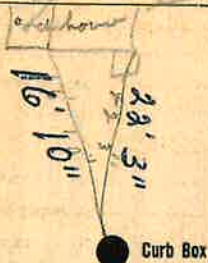

6" Main Elev. of Main at tap 4"

Gate at 9" to main Gate at

3/4" copper Curb Box