


Labor and Materials

Lead Connection	\$
Curb Cock	\$
Service Box { Short 3½ x 4½ Old-returned { Long 4½ x 5½ Buffalo	\$
2.0 Ft. ¾-in. G. I. Pipe at	\$
Nipples.....in. at	\$
Bushings.....to.....in. at	\$
Red'g Coup.....to.....in. at	\$
Ine'g Coup.....to.....in. at	\$
Union.....in. at	\$
Meter.....in. at	\$
Cu. Yds. Br. Stone at	\$
Cu. Yds. Sand at	\$
Bags Cement at	\$
Paving Brick { Mack Red Asphalt } at	\$
Hrs. Foreman at	\$
Hrs. Common Labor at	\$
Hrs. Mason at	\$
Hrs.....at	\$
Hrs.....at	\$
Builders' Use of Water	\$
.....at	\$
.....at	\$
.....at	\$
.....at	\$
Total	\$		

Labor and Material Report July 11 1918

no 57 Maple St

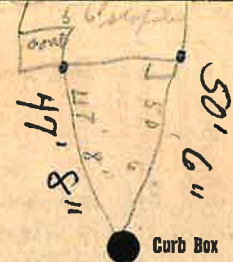

6 Main Elev. of Main at tap 4'

Gate at ● 20' to MAIN ● Gate at

3/4" copper ● Curb Box