

STAPLE


St. Pl. Ave. No. 5

Name of Owner

MACERO

Labor and Mat'l. Report

19

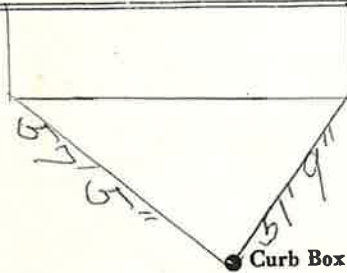

Main

Elev. of Main at tap

Gate at ●

● Gate at

● Curb Box

STAPLE


St. Pl. Ave. No. 5

Name of Owner

MACERO

Labor and Mat'l. Report

JAN 22 19 82

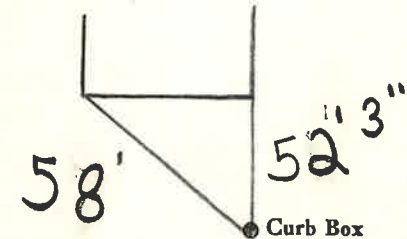

6" Main

Elev. of Main at tap

Gate at ●

● Gate at

Bh 1-22-82

● Curb Box

LABOR AND MATERIALS

Copper } Connection		\$
Lead } }		
Curb } Cock	} in.	\$
Valve		
T. S. & V.		
Service box { Short 3½ x 4½	}	\$
Old returned { Long 4½ x 5½		
Buff or Rdway		
Ft. in. { Copper	} Pipe at	\$
G. I.		
C. I.		
Nipples	in. at	\$
Bushings	to in. at	\$
Red'g } Coupl'gs	to in. at	\$
Inc'g		
Union	in. at	\$
Meter	in. at	\$
Lead Joints	at	\$
Compound Joints	at	\$
Maintenance Foreman		\$
Hrs. Water Maint. Man—1	at	\$
Hrs. Water Maint. Man—2	at	\$
Hrs. Garage Foreman	at	\$
Hrs. Labor—	at	\$
Hrs. Compressor	at	\$
Compensation Ins. at \$	per C	\$
Trucking		\$
Pav't Patch		\$
		\$
		\$
		\$
O'head		\$
		\$

LABOR AND MATERIALS

Copper } Connection		\$
Lead } }		
Curb } Cock	} in.	\$
Valve		
T. S. & V.		
Service box { Short 3½ x 4½	}	\$
Old returned { Long 4½ x 5½		
Buff or Rdway		
Ft. in. { Copper	} Pipe at	\$
G. I.		
C. I.		
Nipples	in. at	\$
Bushings	to in. at	\$
Red'g } Coupl'gs	to in. at	\$
Inc'g		
Union	in. at	\$
Meter	in. at	\$
Lead Joints	at	\$
Compound Joints	at	\$
Maintenance Foreman		\$
Hrs. Water Maint. Man—1	at	\$
Hrs. Water Maint. Man—2	at	\$
Hrs. Garage Foreman	at	\$
Hrs. Labor—	at	\$
Hrs. Compressor	at	\$
Compensation Ins. at \$	per C	\$
Trucking		\$
Pav't Patch		\$
		\$
		\$
		\$
O'head		\$
		\$