


LABOR AND MATERIALS

Copper Lead	} Connection	\$	
Curb	{ Clock Valve T. S. & V. } in.	\$	
Service box	{ Short 3 1/4 X 4 1/4 Long 4 1/4 X 5 1/4 Buff or Rdway }	\$	
Old returned				
Ft.	{ Copper Galv. Iron Cast Iron } in.	\$	Pipe at
Nipples	 in. at		\$
Bushings	 to	\$	in. at
Red'g Inc'g	{ Couplings to	\$	in. at
Union	 in. at		\$
Meter	 in. at	\$	
Lead Joints		at	\$	
Compound Joints		at	\$	
Hrs. Foreman		at	\$	
Hrs. Chauffeur		at	\$	
Hrs. Tapper		at	\$	
Hrs. Labor		at	\$	
Hrs. Labor		at	\$	
Hrs. Compressor		at	\$	
Compensation Ins.			\$	
Trucking			\$	
Builders Use of Water			\$	
			\$	
			\$	
St. Pl. Ave. No. 63

Name of Owner
TAX ID# 309.11-14-7

Labor and Mat'l. Report July 7 1947

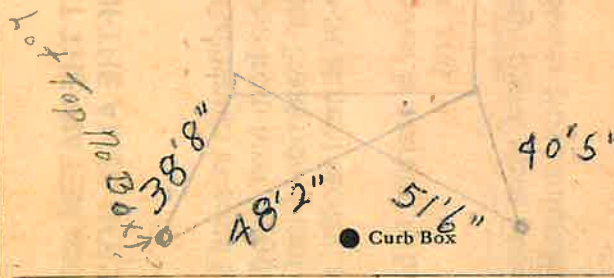

Elev. of Main at tap.....

Gate at ● Gate at ●

● Curb Box