

ALSO CALLED 73A+B

STAPLE


St. No. 73R
Ave. No.

Name of Owner

TAX ID # 309.11-14-3.1

Labor and Mat'l. Report

19 99

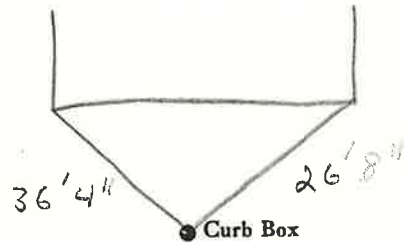

Main Elev. of Main at tap

Gate at ●

● Gate at

● Curb Box

NOTE - THIS HOUSE IS IN
BACK OF #73

LSM-5C-6-1-67

STAPLE


St. No. 73
Ave. No.

Name of Owner

TAX ID # 309.11-14-2

Labor and Mat'l. Report

19 99

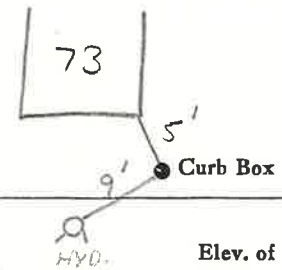

Main Elev. of Main at tap

Gate at ●

● Gate at

● Curb Box

NOTE - THIS HOUSE IS
ABOUT 150' FROM STAPLE ST
AND IN BACK OF #75

LSM-5C-6-1-67

Apr. 1999

