

Labor and Materials


Copper } Connection		\$
Lead } Connection		\$
Curb } Cock Valve	in.	\$
	T. S. & V.	\$
Service Box } Short 3/4x4 1/2		\$
Old returned } Long 4 1/2x5 1/2		\$
	Buff. or Rdway	\$
24 Ft. } in. } Copper	Pipe at	\$
		\$
		\$
Nipples	in. at	\$
Bushings	to in. at	\$
Red'g } Couplings	to in. at	\$
Inc'g }		\$
Union	in. at	\$
Meter	in. at	\$
Lbs. Br. Stone	at	\$
Lbs. Sand	at	\$
Bags Cement	at	\$
Paving Brick } Mack	at	\$
	Red	\$
	Asphalt	\$
Lead Joints	at	\$
Leadite Joints	at	\$
Hrs. Foreman	at	\$
Hrs. Common Labor	at	\$
Hrs. Common Labor	at	\$
Hrs. Mason	at	\$
Hrs. Mason's Helper	at	\$
Hrs. Compressor	at	\$
Compensation Ins		\$
Trucking		\$
Builders' Use of Water		\$
Total \$		\$

Labor and Material Report

28 66

19 28

75

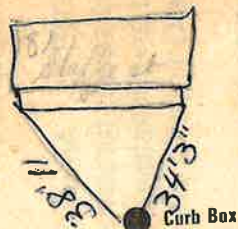

6" Main

Elev of Main at tap 4'

Gate at

TAX ID # 309.11-14-1

Gate at

● Curb Box

Guy Lilly

This house

has #75

on it - on
street it - not near

3/4" COPPER

24' to MAIN