

Labor and Material Report

Aug 24

1928

3/4 tap 9 Stable at vacant lot
west side



6" Main

Elev of Main at tap

Gate at ●

● Gate at

● Curb Box

Lot No 15
to have 1/2" pipe

St.

Pl. 9


Ave. No. 9

Name of Owner

Labor and Mat'l. Report

OCT. 12

19 24

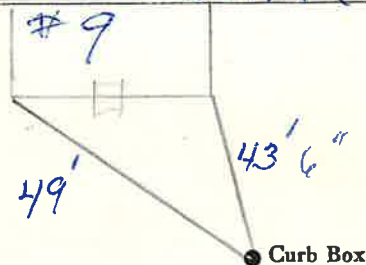

Main

Elev. of Main at tap

Gate at ●

● Gate at

22' to main

NEW TAP
3/4" COPPER

● Curb Box

TAX ID# 309.11-5-25

Labor and Materials


1/	Copper } Connection ^{3/4}		\$	
	Lead			
1/	Curb } Cock Valve } ^{3/4} in.		\$	
		T. S. & V.		
1/	Service Box } Short 3 1/2 x 4 1/2		\$	
	Old returned } Long 4 1/2 x 5 1/2			
		Buff. or Rdway		
2 1/2	Ft. ^{3/4} in. } Copper	Pipe at	\$	
		Galv. Iron		
		Cast Iron		
	Nipples	in. at	\$	
	Bushings	to in. at	\$	
	Red'g } Couplings	to in. at	\$	
	Inc'g			
	Union	in. at	\$	
	Meter	in. at	\$	
	Lbs. Br. Stone	at	\$	
	Lbs. Sand	at	\$	
	Bags Cement	'at	\$	
	Paving Brick } Mack	} at	\$	
				Red
				Asphalt
	Lead Joints	at	\$	
	Leadite Joints	at	\$	
	Hrs. Foreman	at	\$	
	Hrs. Common Labor	at	\$	
	Hrs. Common Labor	at	\$	
	Hrs. Mason	at	\$	
	Hrs. Mason's Helper	at	\$	
	Hrs. Compressor	at	\$	
	Compensation Ins.		\$	
	Trucking		\$	
	Builders' Use of Water		\$	
	Total	\$		

LABOR AND MATERIALS

	Copper } Connection		\$
	Lead		
	Curb } Cock Valve } in.		\$
		T. S. & V.	
	Service box } Short 3 1/2 x 4 1/2		\$
	Old returned } Long 4 1/2 x 5 1/2		
		Buff. or Rdway	
22	Ft. ^{3/4} in. } Copper	Pipe at	\$
		G.I.	
		C.I.	
	Nipples	in. at	\$
	Bushings	to in. at	\$
	Red'g } Coupl'gs	to in. at	\$
	Inc'g		
	Union	in. at	\$
	Meter	in. at	\$
	Lead Joints	at	\$
	Compound Joints	at	\$
	Maintenance Foreman		\$
	Hrs. Water Maint. Man—1	at	\$
	Hrs. Water Maint. Man—2	at	\$
	Hrs. Garage Foreman	at	\$
	Hrs. Labor	at	\$
	Hrs. Compressor	at	\$
	Compensation Ins. at \$	per C	\$
	Trucking		\$
	Pav't Patch		\$
			\$
			\$
			\$
	O'head		\$
			\$

Labor and Materials

1	Copper } Connection	3/4	\$
	Lead }		
1	Curb } Cock Valve	3/4 in.	\$
	T. S. & V. }		
1	Service Box } Short 3 1/2 x 4 1/2		\$
	Old returned } Long 4 1/2 x 5 1/2		
		Bull. or Rdway	\$
24	Ft. 3/4 in. } Copper Galv. Iron	Pipe at	\$
		Cast Iron	\$
	Nipples	in. at	\$
	Bushings	to in. at	\$
	Red'g } Couplings	to in. at	\$
	Inc'g }		
	Union	in. at	\$
	Meter	in. at	\$
	Lbs. Br. Stone	at	\$
	Lbs. Sand	at	\$
	Bags Cement	at	\$
	Paving Brick } Mack Red Asphalt	at	\$
	Lead Joints	at	\$
	Leadite Joints	at	\$
	Hrs. Foreman	at	\$
	Hrs. Common Labor	at	\$
	Hrs. Common Labor	at	\$
	Hrs. Mason	at	\$
	Hrs. Mason's Helper	at	\$
	Hrs. Compressor	at	\$
	Compensation Ins.	at	\$
	Trucking	at	\$
	Builders' Use of Water	at	\$
	Total	\$	

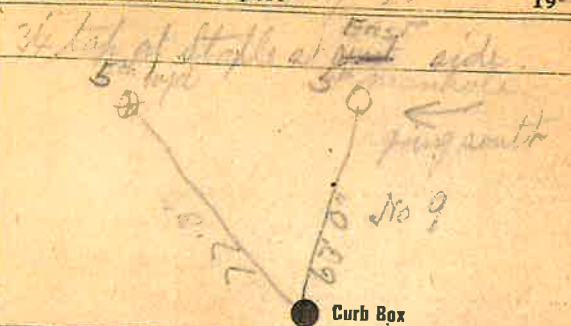

6" Main Elev of Main at tap *4.11*
 Gate at ● ● Gate at

● Curb Box
Lot 64
~~Franklin~~
 Kattowback
 Chester, Tenn