

Labor and Material Report *Aug 24* 1928

3/4 tap at 11 staple at west side



6 Main Elev of Main at tap *4.1*
 Gate at ● ● Gate at

● Curb Box

LOT NO 16
Char Wright

Staple


St. *11*
~~Pl.~~
 Ave. No. *11*

Name of Owner

Macerio

Labor and Mat'l. Report

19 86

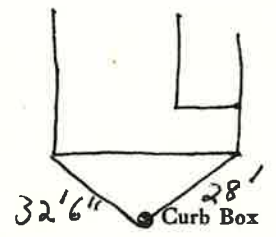

Main Elev. of Main at tap
 Gate at ● ● Gate at

31' to main

3/4" copper ● Curb Box

TAX ID# 309.11-5-24

Labor and Materials


1	Copper } Connection $3/4$ "	\$
1	Lead } Cock Valve } $3/4$ " in.	\$
	T-S. & V. }	
1	Service Box } Short $3\frac{1}{2}$ x $4\frac{1}{2}$	\$
	Old returned } Long $4\frac{1}{2}$ x $5\frac{1}{2}$	
	Buff. or Rdway }	
24	Ft. $3/4$ " in. } Copper } Pipe at	\$
	Galv. Iron }	
	Cast Iron }	
	Nipples..... in. at	\$
	Bushings..... to..... in. at	\$
	Red'g } Couplings..... to..... in. at	\$
	Inc'g }	
	Union..... in. at	\$
	Meter..... in. at	\$
	Lbs. Br. Stone at	\$
	Lbs. Sand at	\$
	Bags Cement 'at	\$
	Paving Brick } Mack } at	\$
	Red }	
	Asphalt }	
	Lead Joints at	\$
	Leadite Joints at	\$
	Hrs. Foreman at	\$
	Hrs. Common Labor at	\$
	Hrs. Common Labor at	\$
	Hrs. Mason at	\$
	Hrs. Mason's Helper at	\$
	Hrs. Compressor at	\$
	Compensation Ins.	\$
	Trucking	\$
	Builders' Use of Water	\$
	Total \$	

LABOR AND MATERIALS

Copper } Connection	\$	
Lead } Cock Valve } in.	\$	
Curb } T. S. & V. }		
Service box } Short $3\frac{1}{2}$ x $4\frac{1}{2}$	\$	
Old returned } Long $4\frac{1}{2}$ x $5\frac{1}{2}$		
Buff. or Rdway }		
31 Ft. $3/4$ " in. } Copper } Pipe at	\$	
	G. I. }	
	C. I. }	
Nipples..... in. at	\$	
Bushings..... to..... in. at	\$	
Red'g } Coupl'gs..... to..... in. at	\$	
Inc'g }		
Union..... in. at	\$	
Meter..... in. at	\$	
Lead Joints at	\$	
Compound Joints at	\$	
Maintenance Foreman	\$	
Hrs. Water Maint. Man—1 at	\$	
Hrs. Water Maint. Man—2 at	\$	
Hrs. Garage Foreman..... at	\$	
Hrs. Labor—..... at	\$	
Hrs. Compressor at	\$	
Compensation Ins. at \$..... per C	\$	
Trucking	\$	
Pav't Patch	\$	
	\$	
	\$	
	\$	
O'head	\$	
	\$	

July 16

no 9 stope st.

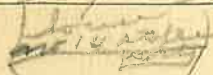

● Curb Box

Main

Elev. of Main at tap 5'


at ●

● Gate at

● Curb Box

July 16

no 11 stope st.

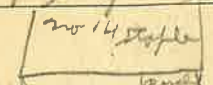

● Curb Box

6" Main

Elev. of Main at tap 4'

Gate at ●

● Gate at

● Curb Box

Labor and Materials

Lead Connection	14	\$
Curb Cock	2	\$
Service Box	{ Short 3½ x 4½			
Old returned	{ Long 4½ x 5½		\$
	{ Buffalo			
Ft. 3 in. G. I. Pipe at		\$
Nipples in. at	\$
Bushings to..... in. at	\$
Red'g Coup to..... in. at	\$
Inc'g Coup to..... in. at	\$
Union in. at	\$
Meter in. at	\$
Cu. Yds. Br. Stone at		\$
Cu. Yds. Sand at		\$
Bags Cement at		\$
Paving Brick	{ Mack Red Asphalt }	at	\$
Hrs. Foreman at		\$
Hrs. Common Labor at		\$
Hrs. Mason at		\$
Hrs. at	\$
Hrs. at	\$
Builders' Use of Water		\$
 at	\$
 at	\$
 at	\$
 at	\$
Total			\$

Labor and Materials

Lead Connection	7	\$
Curb Cock	3	\$
Service Box	{ Short 3½ x 4½			
Old returned	{ Long 4½ x 5½		\$
	{ Buffalo			
I. O. Ft. 3 in. G. I. Pipe at		\$
Nipples in. at	\$
Bushings to..... in. at	\$
Red'g Coup to..... in. at	\$
Inc'g Coup to..... in. at	\$
Union in. at	\$
Meter in. at	\$
Cu. Yds. Br. Stone at		\$
Cu. Yds. Sand at		\$
Bags Cement at		\$
Paving Brick	{ Mack Red Asphalt }	at	\$
Hrs. Foreman at		\$
Hrs. Common Labor at		\$
Hrs. Mason at		\$
Hrs. at	\$
Hrs. at	\$
Builders' Use of Water		\$
 at	\$
 at	\$
 at	\$
 at	\$
Total			\$