

LABOR AND MATERIALS

Copper	} Connection		\$	
Lead				
Curb	} Cock Valve T. S. & V.	in.	\$	
Service box		} Short 3½ x 4½ Long 4½ x 5½		
Old returned				\$
9 Ft.	} Copper G.I. G.I.	¾ in. Pipe at	\$	
Nipples		in. at	\$	
Bushings		to in. at	\$	
Red'g	} Coupl'gs	to in. at	\$	
Inc'g				
Union	in. at	\$		
Meter	in. at	\$		
Compound Joints	at	\$		
Maintenance Foreman		\$		
Hrs. Water Maint. Man-1	at	\$		
Hrs. Water Maint. Man-2	at	\$		
Hrs. Garage Foreman	at	\$		
Hrs. Labor	at	\$		
Hrs. Compressor	at	\$		
Trucking		\$		
Pav't Patch		\$		
		\$		
		\$		
East State


St. Pt. Ave. No. 1

Name of Owner

TAX ID # 309.16-20-4

Labor and Mat'l. Report

19 89

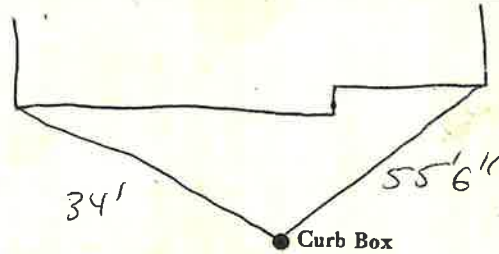

● Curb Box

Main

Elev. of Main at tap

Gate at ●

● Gate at

¾" Copper 9' to main

● Curb Box