


LABOR AND MATERIALS

Copper } Connection _____ \$ _____
 Lead }
 Curb } Cock } _____ in. \$ _____
 } Valve }
 } T. S. & V. }
 Service box { Short 3½ x 4½ }
 Old returned { Long 4½ x 5½ } _____ \$ _____
 Ft. 3/4 in. { Copper } Pipe at _____ \$ _____
 } G.I. }
 } G.I. }
 Nipples _____ in. at _____ \$ _____
 Bushings _____ to _____ in. at _____ \$ _____
 Red'g } Coupl'gs _____ to _____ in. at _____ \$ _____
 Inc'g }
 Union _____ in. at _____ \$ _____
 Meter _____ in. at _____ \$ _____
 _____ \$ _____
 Compound Joints at _____ \$ _____
 Maintenance Foreman _____ \$ _____
 Hrs. Water Maint. Man-1 at _____ \$ _____
 Hrs. Water Maint. Man-2 at _____ \$ _____
 Hrs. Garage Foreman _____ at _____ \$ _____
 Hrs. Labor _____ at _____ \$ _____
 Hrs. Compressor at _____ \$ _____
 _____ \$ _____
 Trucking _____ \$ _____
 Pav't Patch _____ \$ _____
 _____ \$ _____
 _____ \$ _____
 _____ \$ _____
 _____ \$ _____

E. State St. Ave. No. 21
 Pl.

Name of Owner
Bunow

Labor and Mat'l. Report 1991

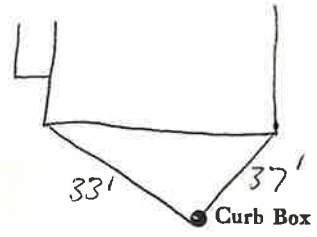

Main _____ Elev. of Main at tap _____
 Gate at • _____ Gate at _____

3/4" Copper

• Curb Box

TAX ID # 309.16-21-3