

LABOR AND MATERIALS


1	Copper	} Connection <u>3/4"</u>	\$
<del>1</del>	<del>Lead</del>		
1	Curb	} <u>3/4</u> in.	\$
	Cock		
	Valve		
	T.S. & V.		
1	Service box	} { Short <u>3 1/2</u> x <u>4 1/2</u> Long <u>4 1/2</u> x <u>5 1/2</u> Buff or Rdway }	\$
	Old returned		
28	Ft. <u>3/4</u> in.	{ Copper G.I. G.I. } Pipe at	\$
	Nipples	in. at	\$
	Bushings	to in. at	\$
	Red'g	} Coupl'gs. to in. at	\$
	Inc'g		
	Union	in. at	\$
	Meter	in. at	\$
	Lead Joints at		\$
	Compound Joints at		\$
	Maintenance Foreman		\$
	Hrs. Water Maint. Man-1 at		\$
	Hrs. Water Maint. Man-2 at		\$
	Hrs. Garage Foreman at		\$
	Hrs. Labor at		\$
	Hrs. Compressor at		\$
	Compensation Ins. at \$	per C	\$
	Trucking		\$
	Pav't Patch		\$
	Tap by <u>Gifford Co.</u>		\$
	<u>2-7-69.</u>		\$
	O'head		\$
			\$

East  
State

St. Pl.  
Ave. No. 24

Name of Owner  
Herbert Wudke.

Labor and Mat'l. Report Feb. 7 1969

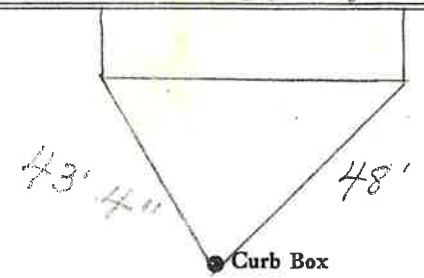

6" Main Elev. of Main at tap 5 1/2'

Gate at • Gate at

3/4" COPPER 28' to MAIN

• Curb Box

TAX ID# 309.16-17-26