

East  
STATE


St.  
Fl.  
Ave. No. 34

Name of Owner

TAX ID # 309.16-17-29

Labor and Mat'l. Report

19

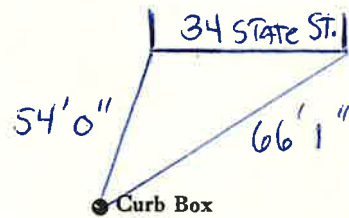

Main

Elev. of  
Main at tap

Gate at ●

● Gate at

● Curb Box

LSM-5C-6-1-67

112/47 East  
STATE ST 34E


St. Fl. lot  
Ave. No. 322-27-28

Name of Owner

Silas Eggleston

Labor and Mat'l. Report

Oct 29 19 47

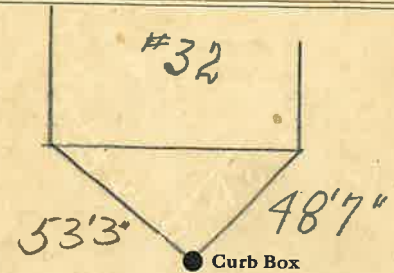

6 Main

Elev. of  
Main at tap 6

Gate at ●

● Gate at

3/4" Copper

22' to MAIN

● Curb Box

LSM-5C-6-1-45

34x36 State St. East

