


LABOR AND MATERIALS

Copper	} Connection	_____	\$ _____	
Lead				
Curb	} Cock } Valve } T. S. & V. }	_____ in.	\$ _____	
Service box		} Short 3½ x 4½ } Long 4½ x 5½ }		
Old returned				\$ _____
15½ Ft. ¾ in.	} Copper } C.I. } C.I.	Pipe at	\$ _____	
Nipples	_____ in. at		\$ _____	
Bushings	_____ to _____ in. at		\$ _____	
Red'g Inc'g	} Coupl'gs	_____ to _____ in. at	\$ _____	
Union		_____ in. at	\$ _____	
Meter	_____ in. at		\$ _____	
			\$ _____	
Compound Joints	at		\$ _____	
Maintenance Foreman			\$ _____	
Hrs. Water Maint. Man-1	at		\$ _____	
Hrs. Water Maint. Man-2	at		\$ _____	
Hrs. Garage Foreman	at		\$ _____	
Hrs. Labor	_____ at		\$ _____	
Hrs. Compressor	at		\$ _____	
			\$ _____	
Trucking			\$ _____	
Pav't Patch			\$ _____	
			\$ _____	
			\$ _____	
			\$ _____	
			\$ _____	

St. _____
 Pt. _____
 Ave. No. 42

Name of Owner _____

Labor and Mat'l. Report _____ 1991

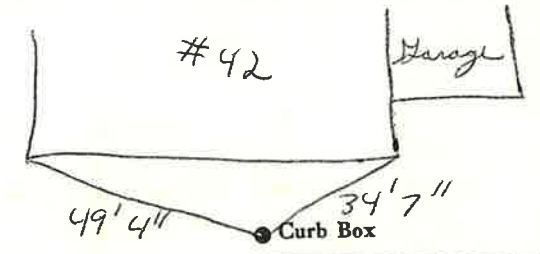

Faxon St
 Main _____ Elev. of Main at tap _____ State St

Gate at • _____ Gate at _____
 ¾" Copper _____ 15½' to main

• Curb Box

#38 on map