

LABOR AND MATERIALS


1 Copper } Connection 3/4" \$  
 Lead }  
 1 Curb } Cock } 3/4 in. 0115291 \$  
 Valve }  
 T.S. & V. }  
 1 Service box } { Short 3 1/2 x 4 1/2 }  
 Old returned } { Long 4 1/2 x 5 1/2 }  
 } { Buff or Rdway } \$  
 11 Ft. 3/4 in. } { Copper } Pipe at \$  
 } { G.I. }  
 } { G.I. }  
 Nipples in. at \$  
 Bushings to in. at \$  
 Red'g }  
 Inc'g } Coupl'gs to in. at \$  
 Union in. at \$  
 Meter in. at \$  
 Lead Joints at \$  
 Compound Joints at \$  
 Maintenance Foreman \$  
 Hrs. Water Maint. Man-1 at \$  
 Hrs. Water Maint. Man-2 at \$  
 Hrs. Garage Foreman at \$  
 Hrs. Labor at \$  
 Hrs. Compressor at \$  
 Compensation Ins. at \$ per C \$  
 Trucking \$  
 Pav't Patch \$  
 Tap by Larreau & Co. \$  
11-3-65. \$  
 O'head \$  
 \$

East State

St. PL  
 Ave. No. 7

Name of Owner  
Leon Mumblo

Labor and Mat'l. Report Nov. 3 1965

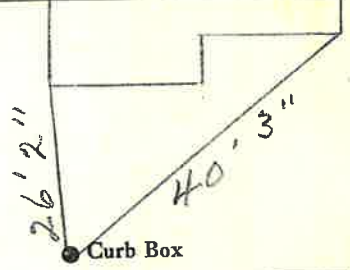

6" Main Elev. of Main at tap 4 1/2'

Gate at ● Gate at ●

TAX ID # 309.16-20-3

11' to main ● Curb Box  
3/4" copper