

LABOR AND MATERIALS


1	Copper	} Connection $\frac{3}{4}$ "	\$
	Lead		
1	Curb	} Cock Valve T.S. & V. } $\frac{3}{4}$ " oriscat	\$
1	Service box	} Short $3\frac{1}{2} \times 4\frac{1}{2}$ Long $4\frac{1}{2} \times 5\frac{1}{2}$ Buff or Rdway	\$
	Old returned		
15	Ft. $\frac{3}{4}$ in.	} Copper G.I. C.I. } Pipe at	\$
	Nipples	in. at	\$
	Bushings	to in. at	\$
	Red'g		
	Inc'g	} Coupl'gs to in. at	\$
	Union	in. at	\$
	Meter	in. at	\$
	Lead Joints	at	\$
	Compound Joints	at	\$
	Maintenance Foreman		\$
	Hrs. Water Maint. Man-1	at	\$
	Hrs. Water Maint. Man-2	at	\$
	Hrs. Garage Foreman	at	\$
	Hrs. Labor	at	\$
	Hrs. Compressor	at	\$
	Compensation Ins.	at \$ per C	\$
	Trucking		\$
	Pav't Patch		\$
	Tap by <i>Large cut Pack + Car</i>		\$
	<i>4-8-71</i>		\$
	O'head		\$

East
State

St.
Pl.
Ave. No. 13

Name of Owner
Fred Sturgis

Labor and Mat'l. Report *April 8 1971*

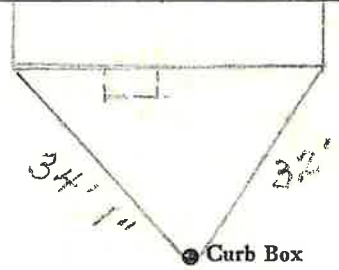

6" Main Elev. of Main at tap 5'

Gate at • Gate at

3/4" Copper 15' to main

With Sewer • Curb Box
Note: - Sewer Main 10' deep.

TAX ID # 309.16-21-5