

# LABOR AND MATERIALS


_____	Copper } Connection	_____	\$	_____
_____	Lead } _____	_____	\$	_____
_____	Curb } Cock	_____ in.	\$	_____
_____	Valve } _____	_____	\$	_____
_____	T.S. & V. } _____	_____	\$	_____
_____	Service box { Short 3-1/2 x 4-1/2 }	_____	\$	_____
_____	Old returned { Long 4-1/2 x 5-1/2 }	_____	\$	_____
33'6"	Ft. 3/4 in. { Copper } Pipe at	_____	\$	_____
_____	Nipples _____ in. at	_____	\$	_____
_____	Bushings _____ to _____ in. at	_____	\$	_____
_____	Red'g _____	_____	\$	_____
_____	Inc'g _____	_____	\$	_____
_____	Union _____ in. at	_____	\$	_____
_____	Meter _____ in. at	_____	\$	_____
_____	_____	_____	\$	_____
_____	Compound Joints at	_____	\$	_____
_____	Maintenance Foreman	_____	\$	_____
_____	Hrs. Water Maint. Man - 1 at	_____	\$	_____
_____	Hrs. Water Maint. Man - 2 at	_____	\$	_____
_____	Hrs. Garage Foreman _____ at	_____	\$	_____
_____	Hrs. Labor _____ at	_____	\$	_____
_____	Hrs. Compressor at	_____	\$	_____
_____	_____	_____	\$	_____
_____	Trucking _____	_____	\$	_____
_____	Pav't Patch _____	_____	\$	_____
_____	_____	_____	\$	_____
_____	_____	_____	\$	_____
_____	_____	_____	\$	_____
_____	_____	_____	\$	_____

EAST STATE <sup>St</sup> 18 EAST  
 Pt. STATE St.,  
 Ave. No. \_\_\_\_\_

Name of Owner \_\_\_\_\_

TAX ID # 309.16-17-7.4

Labor and Mat'l. Report <sup>to</sup> Aug. 31 2002

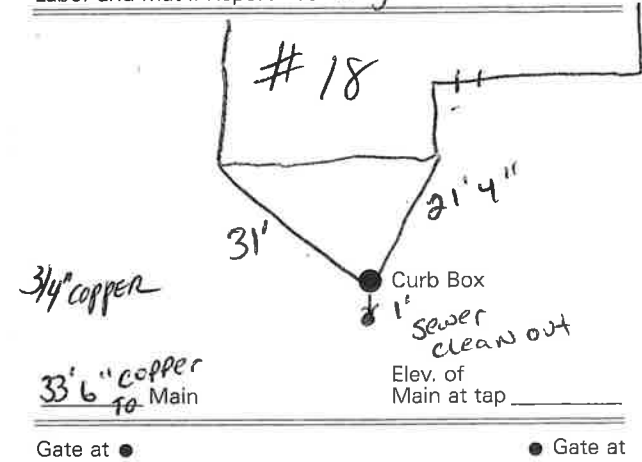

Sewer  
 24'3"  
 From main to  
 outside clean out

9FT Deep  
 SEWER