


LABOR AND MATERIALS

74 } Copper } Connection _____ \$ _____
 } } Cock }
 Curb } Valve } _____ in. _____ \$ _____
 } } T.S. & V. }
 Service box { Short 3-1/2 x 4-1/2 } _____ \$ _____
 Old returned { Long 4-1/2 x 5-1/2 }
 15 Ft. _____ in. { Copper } Pipe at _____ \$ _____
 } }
 Nipples _____ in. at _____ \$ _____
 Bushings _____ to _____ in. at _____ \$ _____
 Red'g _____
 Inc'g _____
 Union _____ in. at _____ \$ _____
 Meter _____ in. at _____ \$ _____
 _____ \$ _____
 Compound Joints at _____ \$ _____
 Maintenance Foreman _____ \$ _____
 Hrs. Water Maint. Man - 1 at _____ \$ _____
 Hrs. Water Maint. Man - 2 at _____ \$ _____
 Hrs. Garage Foreman _____ at _____ \$ _____
 Hrs. Labor _____ at _____ \$ _____
 Hrs. Compressor at _____ \$ _____
 _____ \$ _____
 _____ \$ _____
 Trucking _____ \$ _____
 Pav't Patch _____ \$ _____
 _____ \$ _____
 _____ \$ _____
 _____ \$ _____
 _____ \$ _____

W. STATE St. Ave. No. 19
 Name of Owner _____

Labor and Mat'l. Report 19 _____

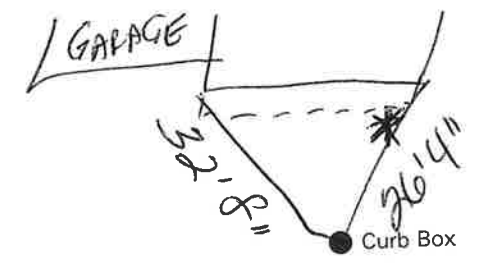

9" Main Elev. of Main at tap 4'
 Gate at ● Gate at ●

15' to MAIN
 ● Curb Box

* OUTSIDE CLEAN-OUT
 RIGHT CORNER