


LABOR AND MATERIALS

_____ Copper } Connection _____ \$ _____	
_____ Lead } _____	
_____ Curb } Cock _____ in. _____ \$ _____	
_____ } Valve _____	
_____ } T.S. & V. _____	
_____ Service box { Short 3-1/2 x 4-1/2 } _____ \$ _____	
_____ Old returned { Long 4-1/2 x 5-1/2 } _____	
25' 7" Ft. 3/4 in. { Copper } Pipe at _____ \$ _____	
_____ } _____	
_____ Nipples _____ in. at _____ \$ _____	
_____ Bushings _____ to _____ in. at _____ \$ _____	
_____ Red'g _____	
_____ Inc'g _____	
_____ Union _____ in. at _____ \$ _____	
_____ Meter _____ in. at _____ \$ _____	
_____ \$ _____	
_____ Compound Joints at _____ \$ _____	
_____ Maintenance Foreman _____ \$ _____	
_____ Hrs. Water Maint. Man - 1 at _____ \$ _____	
_____ Hrs. Water Maint. Man - 2 at _____ \$ _____	
_____ Hrs. Garage Foreman _____ at _____ \$ _____	
_____ Hrs. Labor _____ at _____ \$ _____	
_____ Hrs. Compressor at _____ \$ _____	
_____ \$ _____	
_____ Trucking _____ \$ _____	
_____ Pav't Patch _____ \$ _____	
_____ \$ _____	
_____ \$ _____	
WEST STATE St. Ave. No. 20

Name of Owner ANTHONY POULOS

Labor and Mat'l. Report 19 6-20-2003

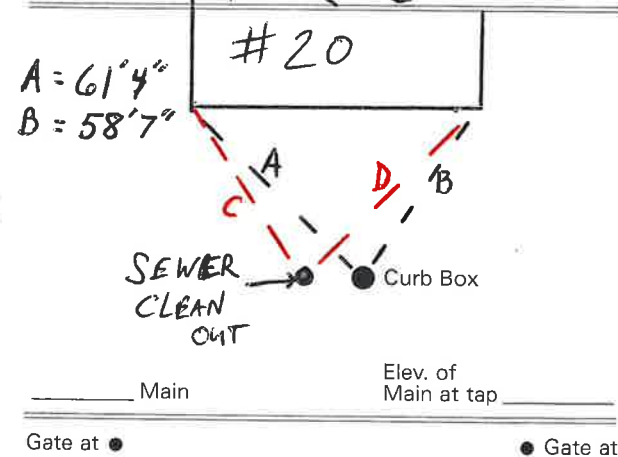

3/4" copper 25' 7" to MAIN

TAX ID # 309.16-19-5 ● Curb Box

C = 61' 2"
D = 59' 3"

DISTANCE FROM CLEAN OUT TO SEWER MAIN IS = 21' 7"