

### LABOR AND MATERIALS


<u>3/4</u>	Copper } Connection _____ \$ _____
	Lead } _____ \$ _____
	Curb } <del>Check</del> Valve } _____ in. \$ _____
	Service box { Short 3-1/2 x 4-1/2 } _____ \$ _____
	Old returned { Long 4-1/2 x 5-1/2 } _____ \$ _____
<u>17</u>	Ft. _____ in. { <del>Gal.</del> Copper } Pipe at _____ \$ _____
	Nipples _____ in. at _____ \$ _____
	Bushings _____ to _____ in. at _____ \$ _____
	Red'g _____ \$ _____
	Inc'g _____ \$ _____
	Union _____ in. at _____ \$ _____
	Meter _____ in. at _____ \$ _____
	_____ \$ _____
	Compound Joints at _____ \$ _____
	Maintenance Foreman _____ \$ _____
	Hrs. Water Maint. Man - 1 at _____ \$ _____
	Hrs. Water Maint. Man - 2 at _____ \$ _____
	Hrs. Garage Foreman _____ at _____ \$ _____
	Hrs. Labor _____ at _____ \$ _____
	Hrs. Compressor at _____ \$ _____
	_____ \$ _____
	Trucking _____ \$ _____
	Pav't Patch _____ \$ _____
	_____ \$ _____
	_____ \$ _____
	_____ \$ _____
	_____ \$ _____

W. STATE

~~W. STATE~~  
St. \_\_\_\_\_  
Ave. No. 21

Name of Owner  
TAX ID# 309.16-16-9.1

Labor and Mat'l. Report 7/2009

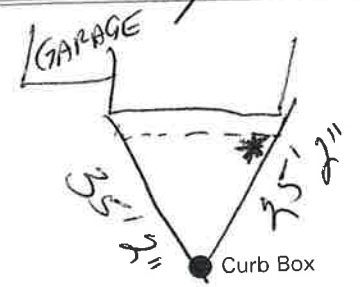

8" Main  
Elev. of Main at tap 4'  
Gate at ● Gate at ●

17' to MAIN  
● Curb Box

\*  
OUT SIDE CLEAN-OUT  
RIGHT CORNER