


### LABOR AND MATERIALS

Copper	Lead	Connection			\$
Curb	}	Cock	in.		\$
		Valve			
		T. S. & V.			
Service box	}	Short $3\frac{1}{2} \times 4\frac{1}{2}$	}		\$
Old returned		Long $4\frac{1}{2} \times 5\frac{1}{2}$			
10 Ft.	$\frac{3}{4}$ in.	}	Pipe at		\$
				Copper	
				G.I. C.I.	
Nipples	in.	at			\$
Bushings	to	in.	at		\$
Red'g	}	Coupl'gs	to	in.	at
Inc'g					
Union	in.	at			\$
Meter	in.	at			\$
					\$
Compound Joints	at				\$
Maintenance Foreman					\$
Hrs. Water Maint. Man-1	at				\$
Hrs. Water Maint. Man-2	at				\$
Hrs. Garage Foreman	at				\$
Hrs. Labor	at				\$
Hrs. Compressor	at				\$
					\$
Trucking					\$
Pav't Patch					\$
					\$
					\$
					\$
					\$

St. \_\_\_\_\_  
 Pt. \_\_\_\_\_  
 Ave. No. 23

Name of Owner \_\_\_\_\_  
W. State

TAX ID # 309.116-116-11

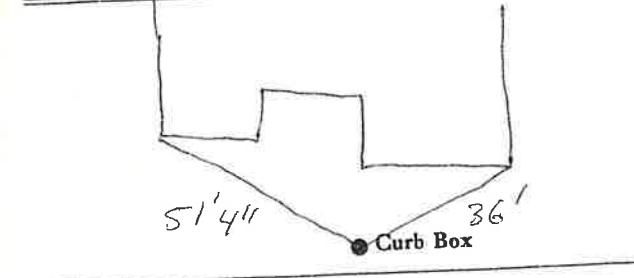

	Elev. of
Main	Main at tap
Gate at ●	● Gate at

$\frac{3}{4}$ " copper 10' to main

● Curb Box