


LABOR AND MATERIALS

Copper	} Connection	_____	\$ _____		
Lead					
Curb	} Cock	_____ in.	\$ _____		
				} Valve	
					} T. S. & V.
Service box	} Short 3½ x 4½	_____	\$ _____		
Old returned				Long 4½ x 5½	
10 Ft.	} 3/4 in.	} Copper	} Pipe at _____	\$ _____	
					} G. I.
Nipples	_____ in. at _____	\$ _____			
Bushings	_____ to _____ in. at _____	\$ _____			
Red'g	} Coupl'gs	_____ to _____ in. at _____	\$ _____		
Inc'g					
Union	_____ in. at _____	\$ _____			
Meter	_____ in. at _____	\$ _____			
_____			\$ _____		
Compound Joints	at _____	\$ _____			
Maintenance Foreman	_____	\$ _____			
Hrs. Water Maint. Man-1	at _____	\$ _____			
Hrs. Water Maint. Man-2	at _____	\$ _____			
Hrs. Garage Foreman	at _____	\$ _____			
Hrs. Labor	_____ at _____	\$ _____			
Hrs. Compressor	at _____	\$ _____			
_____			\$ _____		
Trucking	_____	\$ _____			
Pav't Patch	_____	\$ _____			
_____			\$ _____		
_____			\$ _____		
_____			\$ _____		
_____			\$ _____		

W. State St. Ave. No. 25
 Name of Owner _____
 TAX ID # 309.15-14-8

Labor and Mat'l. Report 1987

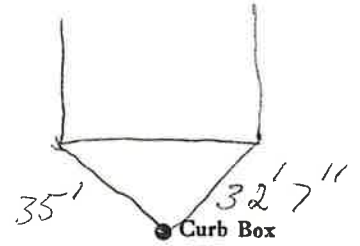

Main _____ Elev. of Main at tap _____
 Gate at • _____ Gate at _____
 3/4" Copper 10' to MAIN
 • Curb Box