

### LABOR AND MATERIALS

Copper	} Connection				
Lead				\$	
Curb	Cook Valve	} in.		\$	
	T. S. & V.				
Service box	} Short 3½ x 4½				
Old returned					
				\$	
31 Ft. 3/4 in.	} Copper	} Pipe at		\$	
	G.I.				
Nipples	in. at			\$	
Bushings	to in. at			\$	
Red'g	} Coupl'gs	to in. at		\$	
Inc'g					
Union	in. at			\$	
Meter	in. at			\$	
				\$	
Compound Joints	at			\$	
Maintenance Foreman				\$	
Hrs. Water Maint. Man	1 at			\$	
Hrs. Water Maint. Man	2 at			\$	
Hrs. Garage Foreman	at			\$	
Hrs. Labor	at			\$	
Hrs. Compressor	at			\$	
				\$	
Trucking				\$	
Pav't Patch				\$	
				\$	
				\$	
				\$	
				\$	


St.  
~~Pt.~~  
 Ave. No. 26

W. State

Name of Owner \_\_\_\_\_

TAX ID # 309.16-19-7

Labor and Mat'l. Report 19 89

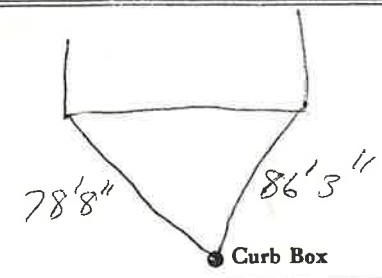

	Elev. of
Main	Main at tap
Gate at ●	● Gate at
<u>3/4 copper</u>	<u>31' to MAIN</u>
	● Curb Box