

LABOR AND MATERIALS


Copper	} Connection	_____	\$ _____	
Lead				
Curb	} Cock } Valve } T.S. & V.	_____ in.	\$ _____	
Service box		} Short 3½ x 4½ } Long 4½ x 5½	_____	\$ _____
Old returned				
27 Ft. 3/4" in.	} Copper } G.I. } C.I.	Pipe at _____	\$ _____	
Nipples	_____ in. at _____	\$ _____		
Bushings	_____ to _____ in. at _____	\$ _____		
Red'g Inc'g	} Coupl'gs _____ to _____ in. at _____	\$ _____		
Union		_____ in. at _____	\$ _____	
Meter	_____ in. at _____	\$ _____		
Compound Joints	at _____	\$ _____		
Maintenance Foreman		\$ _____		
Hrs. Water Maint. Man-1	at _____	\$ _____		
Hrs. Water Maint. Man-2	at _____	\$ _____		
Hrs. Garage Foreman	at _____	\$ _____		
Hrs. Labor	at _____	\$ _____		
Hrs. Compressor	at _____	\$ _____		
Trucking		\$ _____		
Pav't Patch		\$ _____		
		\$ _____		
		\$ _____		
		\$ _____		

St.
Pl. Ave. No. 6

W. STATE

Name of Owner
Kubricky

Labor and Mat'l. Report 1988

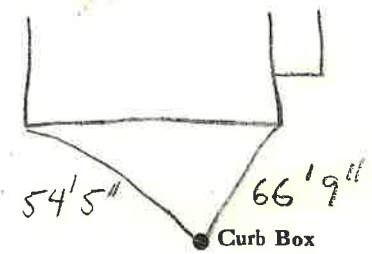

Main	Elev. of Main at tap
Gate at •	• Gate at
<u>3/4" copper</u>	<u>27' to MAIN</u>
• Curb Box	

TAX ID# 309.16-19-2