


LABOR AND MATERIALS

Copper	} Connection	_____	\$		
Lead		_____	\$		
Curb	} Cock	_____ in.	\$		
				} Valve	_____
Service box	} Short 3 1/2 x 4 1/2	_____	\$		
Old returned				} Long 4 1/2 x 5 1/2	_____
29 Ft. 3/4 in.	} Copper	} Pipe at	\$		
				} C.I.	_____
Nipples	_____ in. at	_____	\$		
Bushings	_____ to _____ in. at	_____	\$		
Red'g	} Coupl'gs	_____ to _____ in. at	\$		
Inc'g				_____	
Union	_____ in. at	_____	\$		
Meter	_____ in. at	_____	\$		
Compound Joints at	_____	_____	\$		
Maintenance Foreman	_____	_____	\$		
Hrs. Water Maint. Man-1 at	_____	_____	\$		
Hrs. Water Maint. Man-2 at	_____	_____	\$		
Hrs. Garage Foreman at	_____	_____	\$		
Hrs. Labor- at	_____	_____	\$		
Hrs. Compressor at	_____	_____	\$		
Trucking	_____	_____	\$		
Pav't Patch	_____	_____	\$		
			\$		
			\$		
St. W. STATE
 Pl. _____
 Ave. No. 8

Name of Owner
Lo Cascio

Labor and Mat'l. Report 19 91

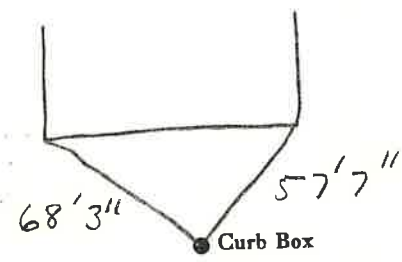

Main _____ Elev. of Main at tap _____
 Gate at • _____ Gate at _____

3/4" Copper 29'40 MAIN
 • Curb Box

TAX ID# 309.16-19-3