

LABOR AND MATERIALS


Copper	} Connection		\$	
Lead				
Curb	} Cock	} in.	\$	
				} Valve
Service box	} Short 3½ x 4½			
Old returned		Long 4½ x 5½	\$	
9 Ft. ¾ in.	} Copper	} Pipe at	\$	
				} G.I.
Nipples	in. at		\$	
Bushings	to	in. at	\$	
Red'g	} Coupl'gs	} to	} in. at	
Inc'g				
Union	in. at		\$	
Meter	in. at		\$	
			\$	
Compound Joints	at		\$	
Maintenance Foreman			\$	
Hrs. Water Maint. Man-1	at		\$	
Hrs. Water Maint. Man-2	at		\$	
Hrs. Garage Foreman	at		\$	
Hrs. Labor	at		\$	
Hrs. Compressor	at		\$	
			\$	
Trucking			\$	
Pav't Patch			\$	
			\$	
			\$	
			\$	
			\$	

W. State

St. 9
 PL. 9
 Ave. No. 9

Name of Owner _____
 TAX ID # 309.16-16-16

Labor and Mat'l. Report 1989

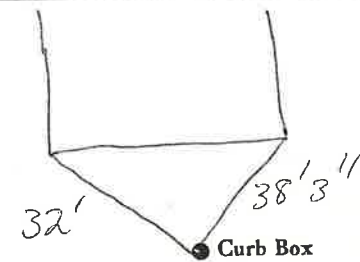

Main _____ Elev. of Main at tap _____
 Gate at • _____ Gate at _____

¾ COPPER _____ 9' to MAIN _____

• Curb Box