

W. State.


St. ~~Pl.~~
Ave. No. 10

Name of Owner

TAX ID # 309.16-19-4

Labor and Mat'l. Report

19 87

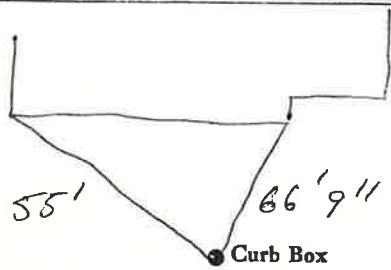

Main Elev. of Main at tap

Gate at • Gate at

3/4" copper 24' to MAIN

• Curb Box


W. State

St. ~~Pl.~~
Ave. No. 10

Name of Owner

Labor and Mat'l. Report

19

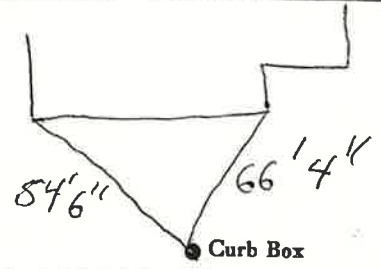

Main Elev. of Main at tap

Gate at • Gate at

3/4" copper 20' to MAIN

• Curb Box

