

West

W. State


St.
Pt.
Ave. No. 12

Name of Owner

Ajone

Labor and Mat'l. Report

Dec 1987

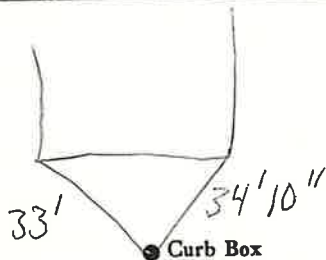

..... Main

Elev. of
Main at tap.....

Gate at •

• Gate at

3/4" Copper

11' to main

• Curb Box


W. State

St.
Pt.
Ave. No. 12

Name of Owner

Labor and Mat'l. Report

19 88

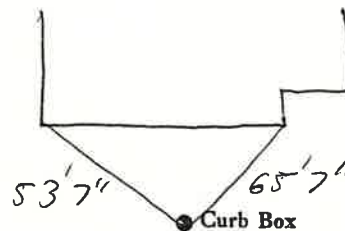

..... Main

Elev. of
Main at tap.....

Gate at •

• Gate at

3/4" COPPER

• Curb Box

