


LABOR AND MATERIALS

Copper	} Connection		\$	
Lead				
Curb	} Cock } Valve } T. S. & V.	in.	\$	
Service box		} Short 3½ x 4½ } Long 4½ x 5½		
Old returned				\$
11 Ft. ¾ in.	} Copper } G.I. } G.I.	Pipe at	\$	
Nipples		in. at	\$	
Bushings		to in. at	\$	
Red'g	} Coupl'gs	to in. at	\$	
Ine'g				
Union	in. at	\$		
Meter	in. at	\$		
			\$	
Compound Joints	at	\$		
Maintenance Foreman		\$		
Hrs. Water Maint. Man—1	at	\$		
Hrs. Water Maint. Man—2	at	\$		
Hrs. Garage Foreman	at	\$		
Hrs. Labor—	at	\$		
Hrs. Compressor	at	\$		
		\$		
Trucking		\$		
Pav't Patch		\$		
		\$		
		\$		
		\$		
		\$		

W. State St. Ave. No. 13  
 Name of Owner Cifone

Labor and Mat'l. Report 1992

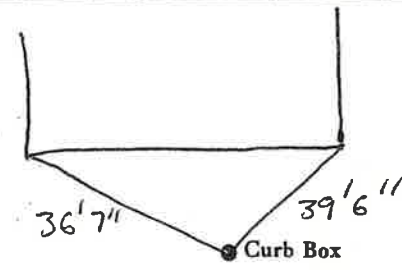

	Elev. of
Main	Main at tap
Gate at ●	● Gate at
¾" copper	11' to MAIN

● Curb Box

TAX ID# 309.16-16-14