


LABOR AND MATERIALS

Copper	} Connection		\$	
Lead				
Curb	} Cock	} in.	\$	
				} Valve
Service box	} Short 3 1/2 x 4 1/2		\$	
Old returned				} Long 4 1/2 x 5 1/2
11 Ft. 3/4 in.	} Copper	} Pipe at	\$	
				} G.I.
Nipples	in. at		\$	
Bushings	to	in. at	\$	
Red'g	} Coupl'gs	to	in. at	\$
Inc'g				
Union	in. at		\$	
Meter	in. at		\$	
			\$	
Compound Joints	at		\$	
Maintenance Foreman			\$	
Hrs. Water Maint. Man—1	at		\$	
Hrs. Water Maint. Man—2	at		\$	
Hrs. Garage Foreman	at		\$	
Hrs. Labor—	at		\$	
Hrs. Compressor	at		\$	
			\$	
Trucking			\$	
Pav't Patch			\$	
			\$	
			\$	
			\$	
			\$	

West  
W. State St. 15  
 Ave. No. 15  
 Name of Owner Cifone

Labor and Mat'l. Report Dec 19 87

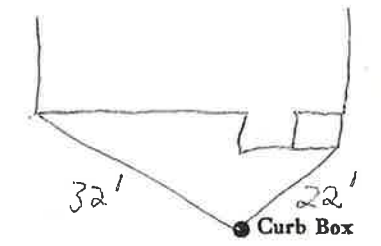

	Main	Elev. of
		Main at tap
Gate at ●		● Gate at
<u>3/4" Copper</u>	<u>11'</u>	<u>to MAIN</u>
	● Curb Box	

TAX ID # 309.16-16-13