


LABOR AND MATERIALS

1 Copper } Connection <sup>3/4"</sup> \$ \_\_\_\_\_  
 1 Lead }  
 1 Curb } Cock } <sup>3/4"</sup> in. \$ \_\_\_\_\_  
 Same } Valve }  
 } T.S. & V. }  
 Service box { Short 3 1/2 x 4 1/2 }  
 Old returned { Long 4 1/2 x 5 1/2 } \$ \_\_\_\_\_  
 } Buff or Rdway }  
 7 Ft. <sup>3/4"</sup> in. { Copper } Pipe at \$ \_\_\_\_\_  
 } G.I. }  
 } C.I. }  
 Nipples..... in. at \$ \_\_\_\_\_  
 Bushings..... to in. at \$ \_\_\_\_\_  
 Red'g }  
 Inc'g } Coupl'gs..... to in. at \$ \_\_\_\_\_  
 Union..... in. at \$ \_\_\_\_\_  
 Meter..... in. at \$ \_\_\_\_\_  
 Lead Joints at \$ \_\_\_\_\_  
 Compound Joints at \$ \_\_\_\_\_  
 Maintenance Foreman \$ \_\_\_\_\_  
 Hrs. Water Maint. Man-1 at \$ \_\_\_\_\_  
 Hrs. Water Maint. Man-2 at \$ \_\_\_\_\_  
 Hrs. Garage Foreman at \$ \_\_\_\_\_  
 Hrs. Labor- at \$ \_\_\_\_\_  
 Hrs. Compressor at \$ \_\_\_\_\_  
 Compensation Ins. at \$ \_\_\_\_\_ per C. \$ \_\_\_\_\_  
 Trucking \$ \_\_\_\_\_  
 Pav't Patch \$ \_\_\_\_\_  
 Tap by G. I. S. GORD \$ \_\_\_\_\_  
 Tap Co. 5-21-59 \$ \_\_\_\_\_  
 O'head \$ \_\_\_\_\_  
 \$ \_\_\_\_\_

St. <sup>V</sup>  
 Pl. Stevens  
 Ave. No. 2

Name of Owner Lambert

Labor and Mat'l. Report May 21 1959

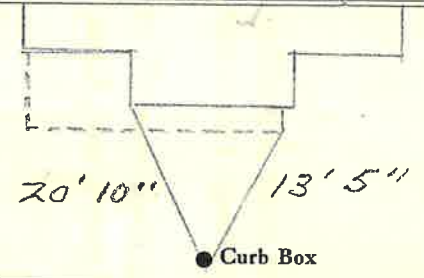

4" Main Elev. of Main at tap 4 1/2"

Gate at • • Gate at

3/4" Copper 7' to MAIN

• Curb Box

TAX ID # 309.7-26-15