

Labor and Materials


1	Copper Lead	Connection	2	\$ 2.60
1	Curb	Cock Valve T. S. & V.	3	\$ 2.30
1	Service Box	Short 3/4 x 1/2	4	\$ 1.40
	Old returned	Long 1/2 x 3/8		
		Bull or Rdway		
21	Ft.	Copper Galv. iron Cast iron	3	\$ 5.57
	Nipples	in. at		\$
	Bushings	to in. at		\$
	Red'g Inc'g	Couplings to in. at		\$
	Union	in. at		\$
	Meter	in. at		\$
	Lbs. Br. Stone	at		\$
	Lbs. Sand	at		\$
	Bags Cement	at		\$
	Paving Brick	Mack Red Asphalt at		\$
	Lead Joints	at		\$
	Leadite Joints	at		\$
3	Hrs. Foreman	at		\$ 1.88
16	Hrs. Common Labor	at		\$ 6.50
	Hrs. Common Labor	at		\$
	Hrs. Mason	at		\$
	Hrs. Mason's Helper	at		\$
	Hrs. Compressor	at		\$
	Compensation Ins.			\$.22
	Trucking			\$ 1.00
	Builders' Use of Water	Patch		\$ 5.00
	Total			\$ 26.47

29-202

Labor and Material Report

Nov 12 1929

15 Stevens St.

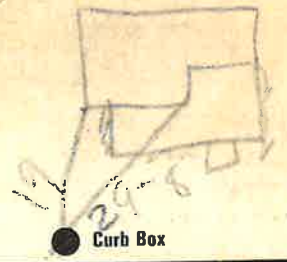

Curb Box

4 Main Eley of Main at tap 4 1/2

Gate at ● copper 21' to MAIN ● Gate at

Curb Box

old tap to be dug up

TAX ID # 309.7-5-2