


LABOR AND MATERIALS

1	Copper	Connection	3/4"	\$
1	Curb	Cock Valve	3/4 in. <i>ORISEAL</i>	\$
1	Service box	Short 3 1/2 x 4 1/2		\$
	Old returned	Long 4 1/2 x 5 1/2		\$
10	3/4 in.	Copper	Pipe at	\$
	Nipples	in. at		\$
	Bushings	to in. at		\$
	Red'g			\$
	Ine'g	Coupl'gs. to in. at		\$
	Union	in. at		\$
	Meter	in. at		\$
	Lead Joints	at		\$
	Compound Joints	at		\$
	Maintenance Foreman			\$
	Hrs. Water Maint. Man-1	at		\$
	Hrs. Water Maint. Man-2	at		\$
	Hrs. Garage Foreman	at		\$
	Hrs. Labor	at		\$
	Hrs. Compressor	at		\$
	Compensation Ins. at \$	per C		\$
	Trucking			\$
	Pav't Patch			\$
	<i>TAP MADE BY PURVIS &amp; CO</i>			\$
	O'head	<i>JAN-3-1975</i>		\$

St. *STEVENS* Avc. No. *6*  
 Name of Owner *JAMES CUMMINGS*  
 Labor and Mat'l. Report *JAN 3 1975*

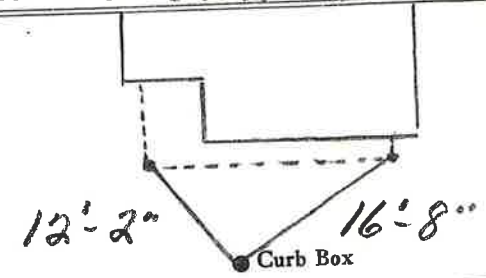

*4"* Main Elev. of Main at tap *5'*  
 Gate at • Gate at •

*3/4" Copper* *10' to main*  
 • Curb Box

*Curb Box inside of Sidewalk (ORSEAL)*

TAX ID # *309.7-6-17*  
 LSM-5C-6-1-67